

**CARD MUST BE SIGNED**

API Number 15- 207-24,885-0000

.....NW.. Sec 21.. Twp 25.. S, Rge 15..  
(location)

.....3740.. Ft North from Southeast Corner of Section  
.....3090... Ft West from Southeast Corner of Section  
(Note: Locate well on Section Plat on reverse side)

Nearest lease or unit boundary line .....450..... feet.

County .....Woodson.....

Lease Name .....Wallace..... Well# .....16.....

**Domestic well within 330 feet :** ☐ yes ☒ no

**Municipal well within one mile :** ☐ yes ☒ no

Depth to Bottom of fresh water .....None..... feet

**Lowest usable water formation** .....

**Depth to Bottom of usable water ..... 225 ..... feet**

**Surface pipe by Alternate :**    1 ☐    2 ☒

**Surface pipe to be set** ..... 40 ..... **feet**

**Conductor pipe if any required .....** feet

**Ground surface elevation ..... feet MSL**

**This Authorization Expires** ..... 12/17/84 .....

Approved By ..... 6/17/84 ..... R

Operator .....

Well Name .....

**Comp Date** ..... **Old Total Depth** .....

**Projected Total Depth** .....1550.....feet

**Projected Formation at TD .....**

**Expected Producing Formations** .....

**I certify that we will comply with K.S.A. 55-101, et seq., plus eventually plugging hole to K.C.C. specifications.**

Date 6/7/84..... Signature of Operator or Agent \_\_\_\_\_

Date .6/7/84..... Signature of Operator or Agent *Lucinda Morris* Title *As Agent*

МНС/КОНЕ 6-7-84

Form C-1 4/84


Must be filed with the K.C.C. five (5) days prior to commencing well  
This card void if drilling not started within six (6) months of date received by K.C.C.

6-784

Important procedures to follow:

1. Notify District office before setting surface casing.
2. Set surface casing by circulating cement to the top.
3. File completion forms ACO-1 with K.C.C. within 90 days of well completion, following instructions on ACO-1, side 1, and including copies of wireline logs.
4. Notify District office 48 hours prior to old well workover or re-entry.
5. Prior to plugging, prepare a plugging plan, then obtain agreement from the appropriate district office for an approved plugging plan.
6. Submit plugging report (CP-4) to K.C.C. after plugging is completed.
7. Obtain an approved injection docket number before disposing of salt water.
8. Notify K.C.C. within 10 days when injection commences or terminates.
9. If an alternate 2 completion, cement in the production pipe from below any usable water to surface within 120 days of spud date.

A Regular Section of Land  
1 Mile = 5,280 Ft.

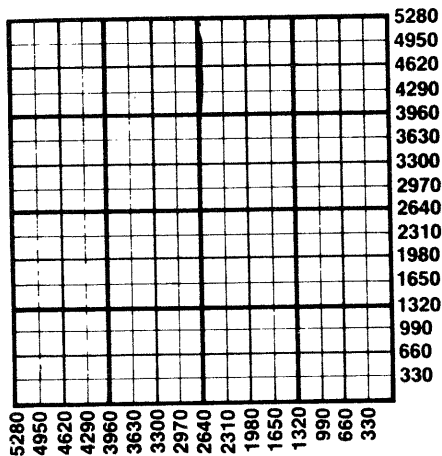

State Corporation Commission of Kansas  
Conservation Division  
200 Colorado Derby Building  
Wichita, Kansas 67202  
(316) 263-3238

RECEIVED  
STATE CORPORATION COMMISSION  
JUN 07 1984  
CONSERVATION DIVISION  
Wichita, Kansas