

CARD MUST BE TYPED

State of Kansas

CARD MUST BE SIGNED

NOTICE OF INTENTION TO DRILL

(see rules on reverse side)

Starting Date May 27 1987
month day year

API Number 15-¹⁴¹⁸⁵207-25,520-0000

OPERATOR: License # 05602
Name N. & B. ENTERPRISES
Address P.O. BOX 884
City/State/Zip CHANUTE, KS. 66720
Contact Person Edd Noland
Phone 316.431-9210

..... SE/4 Sec. 5 Twp. 25 S, Rg. 16 ~~West~~ East
..... 2220 Ft. from South Line of Section
..... 1230 Ft. from East Line of Section

(Note: Locate well on Section Plat on reverse side)

CONTRACTOR: License # 05677
Name J. R. BURRIS DRILLING
City/State P.O. BOX 345 IOLA, KS 66749

Nearest lease or unit boundary line 420 feet
County Woodson
Lease Name Horsch "B" Well # 24

Well Drilled For: Well Class: Type Equipment:
___ Oil ___ SWD Infield Mud Rotary
___ Gas Inj ___ Pool Ext. ___ Air Rotary
___ OWWO ___ Expl ___ Wildcat ___ Cable

Ground surface elevation feet MSL
Domestic well within 330 feet: ___ yes no
Municipal well within one mile: ___ yes no
Depth to bottom of fresh water ¹³⁵
Depth to bottom of usable water ²⁵⁰

If OWWO: old well info as follows:

Operator
Well Name
Comp Date Old Total Depth

Surface pipe by Alternate: 1 ___ 2
Surface pipe planned to be set ²⁰ / 40 minimum
Conductor pipe required
Projected Total Depth 1000 feet
Formation

I certify that well will comply with K.S.A. 55-101, et seq., plus eventually plugging hole to KCC specifications.

Date 5/20/87 Signature of Operator or Agent Edd Noland Title Partner

For KCC Use:

Conductor Pipe Required feet; Minimum Surface Pipe Required ⁴⁰ feet per Alt. 1 (2)
This Authorization Expires 11-22-87 Approved By PA 5-22-87


RECEIVED

Must be filed with the K.C.C. five (5) days prior to commencing well
This card void if drilling not started within six (6) months of date received by K.C.C.

Important procedures to follow:

1. Notify District office before setting surface casing.
2. Set surface casing by circulating cement to the top.
3. File completion forms ACO-1 with K.C.C. within 90 days of well completion, following instructions on ACO-1, side 1, and including copies of wireline logs.
4. Notify District office 48 hours prior to old well workover or re-entry.
5. Prior to filing Intent, prepare a proposed plugging plan in case well is D & A, then obtain approval of plan when calling district office prior to setting surface pipe.
6. Submit plugging report (CP-4) to K.C.C. after plugging is completed.
7. Obtain an approved injection docket number before disposing of salt water.
8. Notify K.C.C. within 10 days when injection commences or terminates.
9. If an alternate 2 completion, cement in the production pipe from below any usable water to surface within 120 days of spud date.

**A Regular Section of Land
1 Mile = 5,280 Ft.**

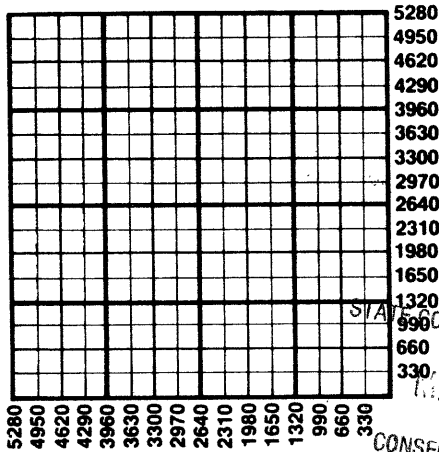

State Corporation Commission of Kansas
Conservation Division
200 Colorado Derby Building
Wichita, Kansas 67202
(316) 263-3238