

CARD MUST BE TYPED

State of Kansas

CARD MUST BE SIGNED

NOTICE OF INTENTION TO DRILL

* CORRECTED CARD

(see rules on reverse side)

Expected Spud Date... June 17 1988
month day year

API Number 15-207-25,554-0000 ✓

OPERATOR: License # 05602
Name N. & B ENTERPRISES
Address P.O. BOX 884
City/State/Zip CHANUTE, KS. 66720
Contact Person Edd Noland
Phone 316.431-9210

SE/4 Sec. 5 Twp. 25 S, Rg. 16
165
2475 *
Ft. from South Line of Section
Ft. from East Line of Section

(Note: Locate well on Section Plat on reverse side)

CONTRACTOR: License # 05677
Name J. R. BURRIS DRILLING
City/State P.O. BOX 345 IOLA, KS. 66749

Nearest lease or unit boundary line 165 feet
County Woodson
Lease Name HORSCH "B" Well # 27

Well Drilled For: Well Class: Type Equipment:
 Oil Storage Infield Mud Rotary
 Gas Inj Pool Ext. Air Rotary
 OWWO Expl Wildcat Cable

Ground surface elevation _____ feet MSL
Domestic well within 330 feet: _____yes no
Municipal well within one mile: _____yes no
Depth to bottom of fresh water _____
Depth to bottom of usable water 250
Surface pipe by Alternate: _____ 1 _____

If OWWO: old well info as follows:

Surface pipe planned to be set 40
Conductor pipe required _____
Projected Total Depth 1000 feet
Formation _____

Operator _____
Well Name _____
Comp Date _____ Old Total Depth _____

I certify that well will comply with K.S.A. 55-101, et seq., plus eventually plugging hole to KCC specifications.
Date 6/7/88 Signature of Operator or Agent Edd Noland Title Partner

For KCC Use:

Conductor Pipe Required _____ feet; Minimum Surface Pipe Required 40 feet per Alt. 2
This Authorization Expires 12-9-88 Approved By R.H. 6-9-88
LKM 9-15-88

EFFECTIVE DATE: 6-14-88


* WAS: 1760' FEL

Must be filed with the K.C.C. five (5) days prior to commencing well
This card void if drilling not started within six (6) months of date received by K.C.C.

Important procedures to follow:

1. Notify District office before setting surface casing.
2. Set surface casing by circulating cement to the top.
3. File completion forms ACO-1 with K.C.C. within 120 days of well spud date, following instructions on ACO-1, side 1, and including copies of wireline logs.
4. Notify District office 48 hours prior to old well workover or re-entry.
5. Prior to filing Intent, prepare a proposed plugging plan in case well is D & A, then obtain approval of plan when calling district office prior to setting surface pipe.
6. Submit plugging report (CP-4) to K.C.C. after plugging is completed.
7. Obtain an approved injection docket number before disposing of salt water.
8. Notify ~~COMMISSION~~ within 10 days when injection commences or terminates.
9. If an alternate 2 completion, cement in the production pipe from below any usable water to surface within 120 days of spud date.

**A Regular Section of Land
1 Mile = 5,280 Ft.**

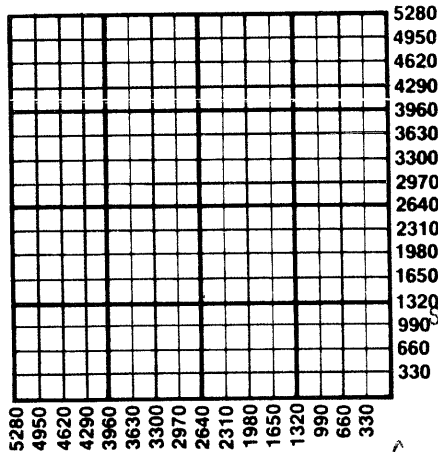

RECEIVED
STATE CORPORATION COMMISSION

JUN - 9 1988
6 9-88
CONSERVATION DIVISION
Wichita, Kansas

State Corporation Commission of Kansas
Conservation Division
200 Colorado Derby Building
Wichita, Kansas 67202-1212
(316) 263-3238