

15-141-21002-00-00
WELL PLUGGING RECORD


STATE OF KANSAS
STATE CORPORATION COMMISSION

Give All Information Completely
Make Required Affidavit
Mail or Deliver Report to:
Conservation Division
State Corporation Commission
800 Bittling Building
Wichita, Kansas

OR
FORMATION PLUGGING RECORD

Strike out upper line
when reporting plug-
ging off formations.

NORTH

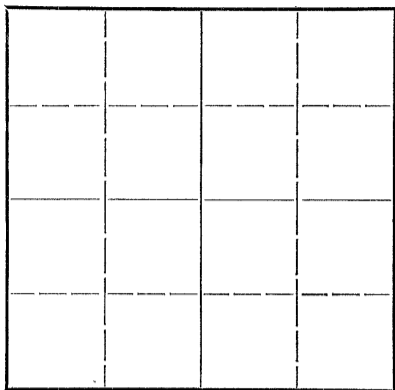

Locate well correctly on above
Section Plat

Osborne County. Sec. 11 Twp 10 Rge 12 (E) (W)
Location as "NE 1/4 NW 1/4 SW 1/4" or footage from lines ~~NE SW SW~~ NW SE SW. ~~NR~~ KCC
Lease Owner Courtney Davis et al
Lease Name III Applegate Well No. #1
Office Address Russell, Kansas
Character of Well (completed as Oil, Gas or Dry Hole) Dry Hole
Date well completed June 2 1950
Application for plugging filed June 2 1950
Application for plugging approved June 2 1950
Plugging commenced June 3 1950
Plugging completed June 3 1950
Reason for abandonment of well or producing formation Dry Hole

If a producing well is abandoned, date of last production 19
Was permission obtained from the Conservation Division or its agents before plugging was com-
menced? Yes

Name of Conservation Agent who supervised plugging of this well Eldon Petty, Hays, Kansas
Producing formation Depth to top Bottom Total Depth of Well 3221 Feet

Show depth and thickness of all water, oil and gas formations.

OIL, GAS OR WATER RECORDS

CASING RECORD

Formation	Content	From	To	Size	Put In	Pulled Out
				10 3/4" Cemented	112.30 From Top	None To Bottom

Describe in detail the manner in which the well was plugged, indicating where the mud fluid was placed and the method or methods used in introducing it into the hold. If cement or other plugs were used, state the character of same and depth placed, from feet to feet for each plug set.

Filled Hole with rotary mud to 110 feet
Plug and bridge set at 110 feet.
20 sacks of cement placed on top of plug at 110 feet.
Filled hole with rotary mud to 20 feet.
Plug and bridge set at 20 feet.
10 sacks of cement on top of plug at 20 feet to top of hole.

RECEIVED
JUN 6-8-1950
JUN 21 1950

(If additional description is necessary, use BACK of this sheet)

Correspondence regarding this well should be addressed to O. G. Stearns
Address Russell, Kansas

STATE OF Kansas, COUNTY OF Russell, ss.
(employee of owner) or (owner or operator) of the above-described well,
being first duly sworn on oath, says: That I have knowledge of the facts, statements, and matters herein contained and the log of the above-
described well as filed and that the same are true and correct. So help me God.

(Signature) O. G. Stearns
Russell, Kansas
(Address)

SUBSCRIBED AND SWORN to before me this 5th day of June 1950
James J. Osborne
Notary Public.

My commission expires June 20, 1953

92-237 7-47-10M
PLUGGING
FILE SEC 11 T 10 R 12 W
BOOK PAGE 9 LINE 27

15-141-~~0002~~⁰¹⁰⁰²-00-00

APPEGATE # 1 WELL

Commenced: 5-24-50
Completion: 6-3-50

Location: ~~NE SW SW~~ NW SE SW, Sec. 11, T10, R12,
Osborne County, Kansas

Elevation: 1744' D. F.

Casing Record:
10-3/4" 112'

Totco:
15 min. 470'
1° 748'
45 min. 870'
1° 1446'
1° 1508'
1° 2057'
45 min. 2267'
45 min. 2645'

WELL LOG

shale	0	310
sand and iron	310	535
shale, red	535	772
<u>Anhydrite</u>	772	810
shale	810	1155
salt	1155	1335
shale and shells	1335	1770
lime	1770	1820
shale and shells	1820	2645
lime	2645	2795
lime and shale	2795	2965
lime	2965	3221
<u>Total Depth</u>	3221	

STATE OF KANSAS)
(SS
COUNTY OF RUSSELL)

I hereby certify that the above information is true and correct to the best of my knowledge.

[Signature]

SUBSCRIBED and sworn before me this 6th day of June, 1950

Harold J. Urbonek
NOTARY PUBLIC

My Commission Expires: June 20, 1953

RECORDED

JUN 8 X 1950

FILE SEC 11 T 10 R 12
BOOK PAGE 9 LINE 27