


STATE OF KANSAS
STATE CORPORATION COMMISSION

WELL PLUGGING RECORD

Give All Information Completely
Make Required Affidavit
Mail or Deliver Report to
Conservation Division
State Corporation Comm.
245 North Water
Wichita, KS 67202

Osborne County, Sec. 8 Twp. 10 Rge. 12 E/W
Location as "NE/CNW $\frac{1}{2}$ SW $\frac{1}{2}$ " or footage from lines
660' FNL 660' FWL C NW NW
Lease Owner Cockrell Oil Corporation
Lease Name Ella Frances Fouts Well No. 1
Office Address 999 The Main Bldg., Houston, Texas 77002
Character of Well (Completed as Oil, Gas or Dry Hole)
Dry Hole

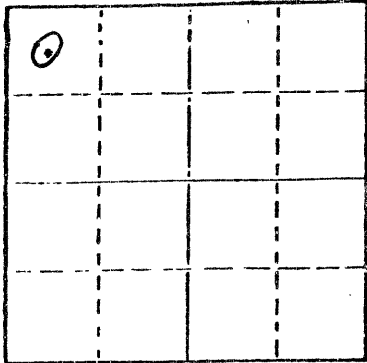

Date Well completed 3-23-1981
Application for plugging filed N/A 19
Application for plugging approved N/A 19
Plugging commenced 3-23-1981
Plugging completed 3-23-1981
Reason for abandonment of well or producing formation
Dry hole

If a producing well is abandoned, date of last production 19

Was permission obtained from the Conservation Division or its agents before plugging was commenced? Yes

Name of Conservation Agent who supervised plugging of this well Duane Rankin
Producing formation Depth to top Bottom Total Depth of Well 4503'
Show depth and thickness of all water, oil and gas formations.

OIL, GAS OR WATER RECORDS

CASING RECORD

FORMATION	CONTENT	FROM	TO	SIZE	PUT IN	PULLED OUT
				8-5/8"	550'	None

Describe in detail the manner in which the well was plugged, indicating where the mud fluid was placed and the method or methods used in introducing it into the hold. If cement or other plugs were used, state the character of same and depth placed, from _____ feet to _____ feet for each plug set.

1st Plug @ 600'	50 sks	50/50 Pozmix + 3% CaCl ₂	
2nd Plug @ 240'	20 sks	50/50 Pozmix + 3% CaCl ₂	
3rd Plug @ 40'	10 sks	50/50 Pozmix + 3% CaCl ₂	w/ Wooden Plug & Hulls
Rathole	5 sks		

RECEIVED

STATE CORPORATION COMMISSION

4-8-81

APR - 8 1981

(If additional description is necessary, use BACK of this sheet)

Name of Plugging Contractor Halliburton; Hays, Kansas
CONSERVATION DIVISION
Wichita, Kansas

STATE OF TEXAS COUNTY OF HARRIS, ss.
Larry R. Tschirhart (employee of owner) or (owner or operator)

of the above-described well, being first duly sworn on oath, says: That I have knowledge of the facts, statements, and matters herein contained and the log of the above-described well as filed and that the same are true and correct. So help me God.

(Signature) Larry R. Tschirhart
Suite 999, The Main Bldg., Houston, TX 77002
(Address)

SUBSCRIBED AND SWORN TO before me this 31st day of March, 1981

Marie Haunth
Notary Public.

My commission expires September 30, 1984