

CARD MUST BE TYPED

State of Kansas

CARD MUST BE SIGNED

SL 85111

NOTICE OF INTENTION TO DRILL

(see rules on reverse side)

Starting Date Dec. 10 1985 month day year

API Number 15- 003-22,704-00-00

OPERATOR: License # 9676 Name Triple M Petroleum Address R.R. # 2 City/State/Zip Garnett, Kansas 66032 Contact Person Richard Miller Phone 913.448.3007

SE 1/4 SE 1/4 Sec. 3 Twp. 22 S, Rg. 19 East 1310 Ft. from South Line of Section 1300 Ft. from East Line of Section

(Note: Locate well on Section Plat on reverse side)

CONTRACTOR: License # 5820 Name Kent Oil Co. City/State Garnett, Kansas 66032

Nearest lease or unit boundary line 10 feet County anderson Lease Name Brownrigg Well # 4 Ground surface elevation NA feet MSL

Well Drilled For: Well Class: Type Equipment: Oil SWD Infield Mud Rotary Gas Inj Pool Ext Air Rotary OWWO Expl Wildcat Cable

Domestic well within 330 feet: yes no Municipal well within one mile: yes no Surface pipe by Alternate: 1 2

IF OWWO: old well info as follows:

Operator Well Name Comp Date Old Total Depth

Depth to bottom of fresh water 75 Depth to bottom of usable water 125 Surface pipe planned to be set 20 Projected Total Depth 870 feet Formation Squirrel

I certify that well will comply with K.S.A. 55-101, et seq., plus eventually plugging hole to KCC specifications.

cementing will be done immediately upon setting production casing

Date 12-4-85 Signature of Operator or Agent Title Manager

For KCC Use:

Conductor Pipe Required feet; Minimum Surface Pipe Required feet per Alt. 2


This Authorization Expires 6-9-86 Approved By 12-9-85

Must be filed with the K.C.C. five (5) days prior to commencing well
This card void if drilling not started within six (6) months of date received by K.C.C.

Important procedures to follow:

1. Notify District office before setting surface casing.
2. Set surface casing by circulating cement to the top.
3. File completion forms ACO-1 with K.C.C. within 90 days of well completion, following instructions on ACO-1, side 1, and including copies of wireline logs.
4. Notify District office 48 hours prior to old well workover or re-entry.
5. Prior to filing Intent, prepare a proposed plugging plan in case well is D & A, then obtain approval of plan when calling district office prior to setting surface pipe.
6. Submit plugging report (CP-4) to K. C. C. after plugging is completed.
7. Obtain an approved injection docket number before disposing of salt water.
8. Notify K.C.C. within 10 days when injection commences or terminates.

**A Regular Section of Land
1 Mile = 5,280 Ft.**

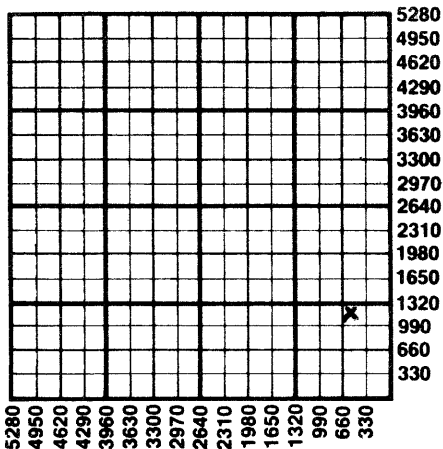

RECEIVED
STATE CORPORATION COMMISSION
Alternative 2 completion, cement in the production pipe from
below any usable water to surface within 120 days of spud date.

DEC 9 1985
12-09-85
CONSERVATION DIVISION
Wichita, Kansas

State Corporation Commission of Kansas
Conservation Division
200 Colorado Derby Building
Wichita, Kansas 67202
(316) 263-3238