

CARD MUST BE TYPED

State of Kansas  
**NOTICE OF INTENTION TO DRILL**  
(see rules on reverse side)

CARD MUST BE SIGNED

Starting Date: ..... 6 - 3 - 85 .....  
month day year

API Number 15- 003-22,638-00-00

OPERATOR: License # 9918  
Name L. Barnes Oil Co.  
Address 6212 Belle Dr.  
City/State/Zip OKC, OK, 73112  
Contact Person L. M. Barnes  
Phone (405) 848-4292

..... C E/2. .... Sec. 9. Twp 22. S, Rge 19. ....  
(location) ☒ East ☐ West

..... 2640 ..... Ft North from Southeast Corner of Section  
..... 1320 ..... Ft West from Southeast Corner of Section  
(Note: Locate well on Section Plat on reverse side)

CONTRACTOR: License # 5820  
Name Milton J. Kent  
City/State 332 W. 8th Garnett, KS. 66032

Nearest lease or unit boundary line ... 220 ..... feet.

County Anderson

Lease Name NWC PL Well# 6

Domestic well within 330 feet : ☐ yes ☒ no

Municipal well within one mile : ☐ yes ☒ no

Well Drilled For:	Well Class:	Type Equipment:
<input checked="" type="checkbox"/> Oil <input type="checkbox"/> Swd	<input checked="" type="checkbox"/> Infield	<input checked="" type="checkbox"/> Mud Rotary
<input type="checkbox"/> Gas <input type="checkbox"/> Inj	<input type="checkbox"/> Pool Ext.	<input type="checkbox"/> Air Rotary
<input type="checkbox"/> OWWO <input type="checkbox"/> Expl	<input type="checkbox"/> Wildcat	<input type="checkbox"/> Cable

Depth to Bottom of fresh water ... None ^80 ..... feet

Lowest usable water formation ..... feet

Depth to Bottom of usable water 125 ..... feet

Surface pipe by Alternate : 1 ☐ 2 ☒

Surface pipe to be set ... 20 ..... feet

Conductor pipe if any required ..... feet

Ground surface elevation ..... feet MSL

This Authorization Expires 11-28-85

Approved By 5-28-85

I certify that we will comply with K.S.A. 55-101, et seq., plus eventually plugging hole to K.C.C. specifications.

RCH for KOME

Date 5 - 25 - 85 Signature of Operator or Agent


*L. M. Barnes*

Title Operator

**Must be filed with the K.C.C. five (5) days prior to commencing well  
This card void if drilling not started within six (6) months of date received by K.C.C.**

**Important procedures to follow :**

**A Regular Section of Land  
1 Mile = 5,280 Ft.**

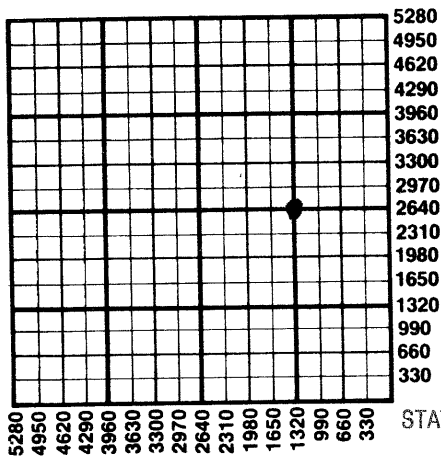

1. Notify District office before setting surface casing.
2. Set surface casing by circulating cement to the top.
3. File completion forms ACO-1 with K.C.C. within 90 days of well completion, following instructions on ACO-1, side 1, and including copies of wireline logs.
4. Notify District office 48 hours prior to old well workover or re-entry.
5. Prior to plugging, prepare a plugging plan, then obtain agreement from the appropriate district office for an approved plugging plan.
6. Submit plugging report (CP-4) to K.C.C. after plugging is completed.
7. Obtain an approved injection docket number before disposing of salt water.
8. Notify K.C.C. within 10 days when injection commences or terminates.
9. If an alternate 2 completion, cement in the production pipe from below any usable water to surface within 120 days of spud date.

RECEIVED

STATE CORPORATION COMMISSION

State Corporation Commission of Kansas

Conservation Division

200 Colorado Derby Building

Wichita, Kansas 67202

(316) 263-3238

MAY 28 1985  
05-28-85  
CONSERVATION DIVISION  
Wichita, Kansas