

CARD MUST BE TYPED

State of Kansas

CARD MUST BE SIGNED

NOTICE OF INTENTION TO DRILL

(see rules on reverse side)

Starting Date May 9 87
month day year

API Number 15— 003-22807-00-00

OPERATOR: License # 5499
 Name .. Brecheisen Oil Co.
 Address ... Box 40
 City/State/Zip .. Garnett, Kansas 66032
 Contact Person .. A. W. Brecheisen
 Phone 913-448-6952

SE. SE SE Sec. 15.. Twp. 22.. S, Rg. 19... X East
 220 Ft. from South Line of Section
 220 Ft. from East Line of Section

(Note: Locate well on Section Plat on reverse side)

CONTRACTOR: License # 5379
 Name .. Kephart Drilling, Inc.
 City/State ... Thayer, Kansas

Nearest lease or unit boundary line 220 feet
 County Anderson
 Lease Name. Wamelsdorf Well # ... 1

Well Drilled For: Well Class: Type Equipment:
X Oil _____ SWD _____ Infield _____ Mud Rotary
 _____ Gas _____ Inj X Pool Ext. X Air Rotary
 _____ OWWO _____ Expl _____ Wildcat _____ Cable

Ground surface elevation feet MSL
 Domestic well within 330 feet: _____ yes X no
 Municipal well within one mile: _____ yes X no
 Depth to bottom of fresh water none
 Depth to bottom of usable water 200' / 25'

If OWWO: old well info as follows:

Surface pipe by Alternate: _____ 1 _____ 2 X
 Surface pipe planned to be set 21'
 Conductor pipe required none
 Projected Total Depth 850 feet
 Formation Squirrel Sand

Operator
 Well Name
 Comp Date Old Total Depth

I certify that well will comply with K.S.A. 55-101, et seq., plus eventually plugging hole to KCC specifications.

Date 5-1-87 Signature of Operator or Agent Lois Hay Title. Acting Agent

For KCC Use:

Conductor Pipe Required feet; Minimum Surface Pipe Required 20 feet per Alt. 8 2
 This Authorization Expires 11-4-87 Approved By 5-4-87

No Drill Alts used.


Pat Hester KC

Must be filed with the K.C.C. five (5) days prior to commencing well
This card void if drilling not started within six (6) months of date received by K.C.C.

Important procedures to follow:

1. Notify District office before setting surface casing.
2. Set surface casing by circulating cement to the top.
3. File completion forms ACO-1 with K.C.C. within 90 days of well completion, following instructions on ACO-1, side 1, and including copies of wireline logs.
4. Notify District office 48 hours prior to old well workover or re-entry.
5. Prior to filing Intent, prepare a proposed plugging plan in case well is D & A, then obtain approval of plan when calling district office prior to setting surface pipe.
6. Submit plugging report (CP-4) to K.C.C. after plugging is completed.
7. Obtain an approved injection docket number before disposing of salt water.
8. Notify K.C.C. within 10 days when injection commences or terminates.
9. If an alternate 2 completion, cement in the production pipe from below any usable water to surface within 120 days of spud date.

A Regular Section of Land 1 Mile = 5,280 Ft.

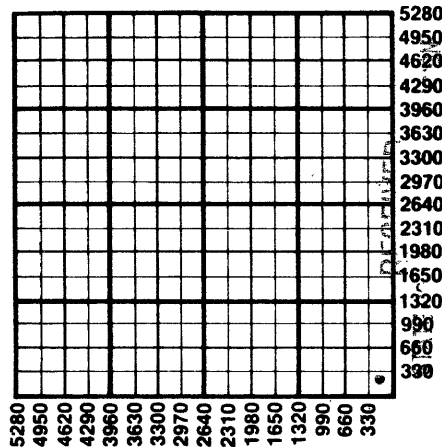

MAY 4 1987
OS-04-87
Conservation Division
Wichita, Kansas

State Corporation Commission of Kansas
Conservation Division
200 Colorado Derby Building
Wichita, Kansas 67202
(316) 263-3238