

CARD MUST BE TYPED

State of Kansas

CARD MUST BE SIGNED

NOTICE OF INTENTION TO DRILL

(see rules on reverse side)

Starting Date 9 10 87
month day year

API Number 15- 003-22828-00-00

OPERATOR: License # 5499
Name Brecheisen Oil Co.
Address Box 40
City/State/Zip Garnett, Kansas 66032
Contact Person A. W. Brecheisen
Phone 913-448-6952

^C
SE SE SE Sec. 15 Twp. 22 S, Rg. 19 East
660 Ft. from South Line of Section
660 Ft. from East Line of Section

(Note: Locate well on Section Plat on reverse side)

CONTRACTOR: License # 5379
Name Kephart Drilling, Inc.
City/State Thayer, Kansas

Nearest lease or unit boundary line 660 feet
County Anderson
Lease Name Womelsdorf Well # 4

Well Drilled For: Well Class: Type Equipment:
 Oil SWD Infield Mud Rotary
 Gas Inj Pool Ext. Air Rotary
 OWWO Expl Wildcat Cable

Ground surface elevation feet MSL
Domestic well within 330 feet: yes no
Municipal well within one mile: yes no
Depth to bottom of fresh water
Depth to bottom of usable water 125'

If OWWO: old well info as follows:

Operator
Well Name
Comp Date Old Total Depth

Surface pipe by Alternate: 1 2
Surface pipe planned to be set 21'
Conductor pipe required none
Projected Total Depth 850 feet
Formation Squirrel

I certify that well will comply with K.S.A. 55-101, et seq., plus eventually plugging hole to KCC specifications.

Date 7-31-87 Signature of Operator or Agent Lois May Title Acting Agent

For KCC Use:


Conductor Pipe Required feet; Minimum Surface Pipe Required feet per Alt. 1
This Authorization Expires 2-3-88 Approved By [Signature] 7-3-87

Must be filed with the K.C.C. five (5) days prior to commencing well
This card void if drilling not started within six (6) months of date received by K.C.C.

Important procedures to follow:

1. Notify District office before setting surface casing.
2. Set surface casing by circulating cement to the top.
3. File completion forms ACO-1 with K.C.C. within 90 days of well completion, following instructions on ACO-1, side 1, and including copies of wireline logs.
4. Notify District office 48 hours prior to old well workover or re-entry.
5. Prior to filing Intent, prepare a proposed plugging plan in case well is D & A, then obtain approval of plan when calling district office prior to setting surface pipe.
6. Submit plugging report (CP-4) to K.C.C. after plugging is completed.
7. Obtain an approved injection docket number before disposing of salt water.
8. Notify K.C.C. within 10 days when injection commences or terminates.
9. If an alternate 2 completion, cement in the production pipe from below any usable water to surface within 120 days of spud date.

A Regular Section of Land 1 Mile = 5,280 Ft.

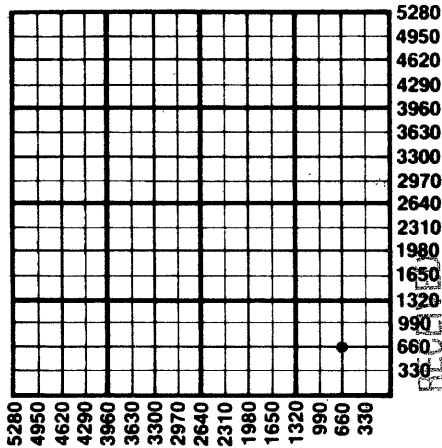

STATE CORPORATION COMMISSION
REC'D

AUG 3 1987
08-03-87
CONSERVATION DIVISION
Wichita, Kansas

State Corporation Commission of Kansas
Conservation Division
200 Colorado Derby Building
Wichita, Kansas 67202
(316) 263-3238