

CARD MUST BE TYPED

State of Kansas

CARD MUST BE SIGNED

# NOTICE OF INTENTION TO DRILL

(see rules on reverse side)

\*CORRECTION\*

As Pits  
Air Rotary

Expected Spud Date..... 9 28 87  
month day year

API Number 15— 003-22,842-00-00

OPERATOR: License # 5499

SE NE SE Sec. 15 Twp. 22 S, Rg. 19  East

Name Brecheisen Oil Co.

1540 Ft. from South Line of Section

Address Box 40

\*\*\* 440 Ft. from East Line of Section

City/State/Zip Garnett, Kansas 66032

(Note: Locate well on Section Plat on reverse side)

Contact Person A. W. Brecheisen

Nearest lease or unit boundary line 440 feet

Phone 913-448-6952

County Anderson

CONTRACTOR: License # 5379

Lease Name Hiatt Well # 1

Name Kephart Drilling, Inc.

Ground surface elevation feet MSL

City/State Thayer, Kansas

Domestic well within 330 feet: yes  no

Well Drilled For: Well Class: Type Equipment:

Municipal well within one mile: yes  no

Oil  Storage  Infield  Mud Rotary

Depth to bottom of fresh water

Gas  Inj  Pool Ext.  Air Rotary

Depth to bottom of usable water 125'

OWWO  Expl  Wildcat  Cable

Surface pipe by Alternate: 1 2

If OWWO: old well info as follows:

Surface pipe planned to be set 21'

Operator

Conductor pipe required none

Well Name

Projected Total Depth 850 feet

Comp Date Old Total Depth

Formation Squirrel

I certify that well will comply with K.S.A. 55-101, et seq., plus eventually plugging hole to KCC specifications.

Date 9-29-87 Signature of Operator or Agent

*Lars Hay*

Title Acting Agent

For KCC Use:

Conductor Pipe Required feet; Minimum Surface Pipe Required 20 feet per Alt.  ②

This Authorization Expires 3-17-88 Approved By F.H. 10-5-87

\*WAS: 220' FEL


DRIB. RCV'D 9-17-87

Must be filed with the K.C.C. five (5) days prior to commencing well  
This card void if drilling not started within six (6) months of date received by K.C.C.

**Important procedures to follow:**

1. Notify District office before setting surface casing.
2. Set surface casing by circulating cement to the top.
3. File completion forms ACO-1 with K.C.C. within 120 days of well spud date, following instructions on ACO-1, side 1, and including copies of wireline logs.
4. Notify District office 48 hours prior to old well workover or re-entry.
5. Prior to filing Intent, prepare a proposed plugging plan in case well is D & A, then obtain approval of plan when calling district office prior to setting surface pipe.
6. Submit plugging report (CP-4) to K.C.C. after plugging is completed.
7. Obtain an approved injection docket number before disposing of salt water.
8. Notify K.C.C. within 10 days when injection commences or terminates.
9. If an alternate 2 completion, cement in the production pipe from below any usable water to surface within 120 days of spud date.

**A Regular Section of Land**  
**1 Mile = 5,280 Ft.**

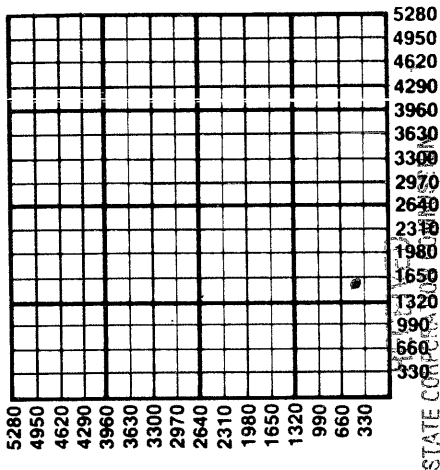

OCT 2 1987  
10-02-87  
CONSERVATION DIVISION  
Wichita, Kansas

State Corporation Commission of Kansas  
Conservation Division  
200 Colorado Derby Building  
Wichita, Kansas 67202-1212  
(316) 263-3238