

CARD MUST BE TYPED

State of Kansas
NOTICE OF INTENTION TO DRILL
(see rules on reverse side)

CARD MUST BE SIGNED

Starting Date: ..12.....29.....1984.....
month day year

API Number 15- 003-22, 551-00-00

OPERATOR: License # ..6081.....

..... SW $\frac{1}{4}$... Sec .21 Twp .22 S, Rge 19. East
(location) West

Name ..H. B. C. OIL CO.....

Address R#1.....

City/State/Zip WELDA, KS. 66091.....

..165..... Ft North from Southeast Corner of Section

Contact Person ..CLYDE BOOTS.....

..3300..... Ft West from Southeast Corner of Section

Phone316.852.3574.....

(Note: Locate well on Section Plat on reverse side)

CONTRACTOR: License # ..5687.....

Nearest lease or unit boundary line165..... feet.

Name ..SUN DRILLING CO.....

County ...ANDERSON.....

City/State ...PIQUA, KS. 66761.....

Lease Name .KACH. WEST. Well# 8.....

Well Drilled For: Well Class: Type Equipment:

Domestic well within 330 feet : yes no

Oil Swd Infield Mud Rotary

Municipal well within one mile : yes no

Gas Inj Pool Ext. Air Rotary

Depth to Bottom of fresh water0..... feet

OWWO Expl Wildcat Cable

Lowest usable water formationNONE.....

If OWWO: old well info as follows:

Depth to Bottom of usable water125..... feet

Operator

Surface pipe by Alternate : 1 2

Well Name

Surface pipe to be set20..... feet

Comp Date Old Total Depth

Conductor pipe if any required0..... feet

Projected Total Depth ..860..... feet

Ground surface elevation1100..... feet MSL

Projected Formation at TD ...DARK SHALE.....

This Authorization Expires 6-27-85

Expected Producing FormationsSQUIRREL.....

Approved By RCH/KCC 12-27-84

I certify that we will comply with K.S.A. 55-101, et seq., plus eventually plugging hole to K.C.C. specifications.

Date 12-24-84 Signature of Operator or Agent


Clyde Boots Title Partner

MHC/KOHE 12/27/84

Must be filed with the K.C.C. five (5) days prior to commencing well
This card void if drilling not started within six (6) months of date received by K.C.C.

Important procedures to follow :

**A Regular Section of Land
1 Mile = 5,280 Ft.**

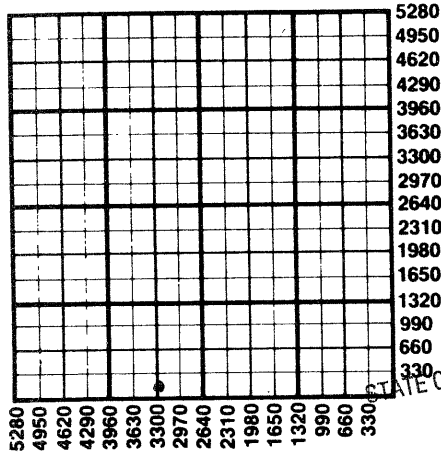

1. Notify District office before setting surface casing.
2. Set surface casing by circulating cement to the top.
3. File completion forms ACO-1 with K.C.C. within 90 days of well completion, following instructions on ACO-1, side 1, and including copies of wireline logs.
4. Notify District office 48 hours prior to old well workover or re-entry.
5. Prior to plugging, prepare a plugging plan, then obtain agreement from the appropriate district office for an approved plugging plan.
6. Submit plugging report (CP-4) to K.C.C. after plugging is completed.
7. Obtain an approved injection docket number before disposing of salt water.
8. Notify K.C.C. within 10 days when injection commences or terminates.
9. After alternate 2 completion, cement in the production pipe from below any usable water to surface within 120 days of spud date.

RECEIVED
STATE CORPORATION COMMISSION
DEC 27 1984
12-27-84
CONSERVATION DIVISION
Wichita, Kansas

State Corporation Commission of Kansas
Conservation Division
200 Colorado Derby Building
Wichita, Kansas 67202
(316) 263-3238