CARD MUST BE TYPED

State of Kansas

NOTICE OF INTENTION TO DRILL

(see rules on reverse side)

CARD MUST BE SIGNED

Starting Date: october 29 1984
month day year

API Number 15- 003-22,533-00-00

OPERATOR: License # 9554
Name OZARK RESOURCES INC.
Address BOX 345
City/State/Zip GARNETT, KS. 66032
Contact Person CLYDE BOOTS
Phone 316 852 3574

NW/¼ (location) Sec 22 Twp 22 S, Rge 19 ☒ East ☐ West

3740 Ft North from Southeast Corner of Section
4180 Ft West from Southeast Corner of Section
(Note: Locate well on Section Plat on reverse side)

CONTRACTOR: License # 5687
Name SUN DRILLING CO.
City/State PIQUA, KS. 66761

Nearest lease or unit boundary line 1100 feet.
County ANDERSON
Lease Name COOPER Well# 16
Domestic well within 330 feet: ☐ yes ☒ no
Municipal well within one mile: ☐ yes ☒ no

Well Drilled For:		Well Class:	Type Equipment:
☒ Oil	☐ Swd	☒ Infield	☒ Mud Rotary
☐ Gas	☐ Inj	☐ Pool Ext.	☐ Air Rotary
☐ OWWO	☐ Expl	☐ Wildcat	☐ Cable

If OWWO: old well info as follows:
Operator
Well Name
Comp Date Old Total Depth

Projected Total Depth 870 feet
Projected Formation at TD DARK SHALE
Expected Producing Formations SQUIRREL

Depth to Bottom of fresh water 0 feet
Lowest usable water formation NONE
Depth to Bottom of usable water 125 feet
Surface pipe by Alternate: 1 ☐ 2 ☒
Surface pipe to be set 20 feet
Conductor pipe if any required 0 feet
Ground surface elevation 1080 feet MSL
This Authorization Expires 4-24-85
Approved By 10-24-84 RC

I certify that we will comply with K.S.A. 55-101, et seq., plus eventually plugging hole to K.C.C. specifications.

Date 10-22-84 Signature of Operator or Agent Clyde Boots Title Shareholder

Form C-1 4/84

MHC/KDHE 10/24/84

Must be filed with the K.C.C. five (5) days prior to commencing well
This card void if drilling not started within six (6) months of date received by K.C.C.

A Regular Section of Land
1 Mile = 5,280 Ft.

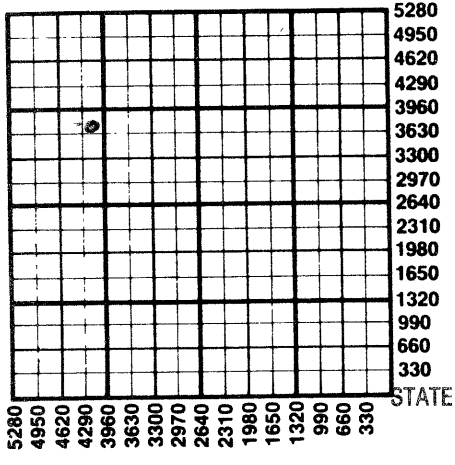

Important procedures to follow:

1. Notify District office before setting surface casing.
2. Set surface casing by circulating cement to the top.
3. File completion forms ACO-1 with K.C.C. within 90 days of well completion, following instructions on ACO-1, side 1, and including copies of wireline logs.
4. Notify District office 48 hours prior to old well workover or re-entry.
5. Prior to plugging, prepare a plugging plan, then obtain agreement from the appropriate district office for an approved plugging plan.
6. Submit plugging report (CP-4) to K.C.C. after plugging is completed.
7. Obtain an approved injection docket number before disposing of salt water.
8. Notify K.C.C. within 10 days when injection commences or terminates.
9. If an alternate 2 completion, cement in the production pipe from below any usable water to surface within 120 days of spud date.

RECEIVED
STATE CORPORATION COMMISSION

OCT 2 4 1984
10-24-84
CONSERVATION DIVISION
Wichita, Kansas

State Corporation Commission of Kansas
Conservation Division
200 Colorado Derby Building
Wichita, Kansas 67202
(316) 263-3238