

CARD MUST BE TYPED

State of Kansas
NOTICE OF INTENTION TO DRILL
(see rules on reverse side)

CARD MUST BE SIGNED

Starting Date: feb 25 85
month day year

API Number 15- 003-22,581-00-00

OPERATOR: License # 9554

SW 1/4 SW 1/4 NW Sec 22... Twp 22... S, Rge 19...
(location) East West

Name OZARK RESOURCES

Address BOX 345

City/State/Zip GARNETT, KANSAS 66032

Contact Person GLYDE BOOTS

Phone 316.852.3574

2860 Ft North from Southeast Corner of Section
5115 Ft West from Southeast Corner of Section
(Note: Locate well on Section Plat on reverse side)

CONTRACTOR: License # 5687

Nearest lease or unit boundary line 220 feet.

County ANDERSON

Name SUN DRILLING Co. Inc.

Lease Name COOPER Well# 17

City/State PIQUA, KS 66761

Domestic well within 330 feet: yes no

Well Drilled For: Well Class: Type Equipment:

Municipal well within one mile: yes no

Oil Swd Infield Mud Rotary
 Gas Inj Pool Ext. Air Rotary
 OWWO Expl Wildcat Cable

Depth to Bottom of fresh water 0 feet

Lowest usable water formation NONE

If OWWO: old well info as follows:

Depth to Bottom of usable water 125 feet

Surface pipe by Alternate: 1 2

Surface pipe to be set 20 feet

Conductor pipe if any required 0 feet

Ground surface elevation 1080 feet MSL

Operator

Well Name

Comp Date Old Total Depth

Projected Total Depth 870 feet

Projected Formation at TD DARK SHALE

Expected Producing Formations SQUIREL

This Authorization Expires 8-21-85

Approved By 1-21-85 R.C.

I certify that we will comply with K.S.A. 55-101, et seq., plus eventually plugging hole to K.G.C. specifications.

Date 2-18-85 Signature of Operator or Agent

Glyde Boots


Title Shareholder

MHC/NOHE 2-21-85

**Must be filed with the K.C.C. five (5) days prior to commencing well
This card void if drilling not started within six (6) months of date received by K.C.C.**

Important procedures to follow :

**A Regular Section of Land
1 Mile = 5,280 Ft.**

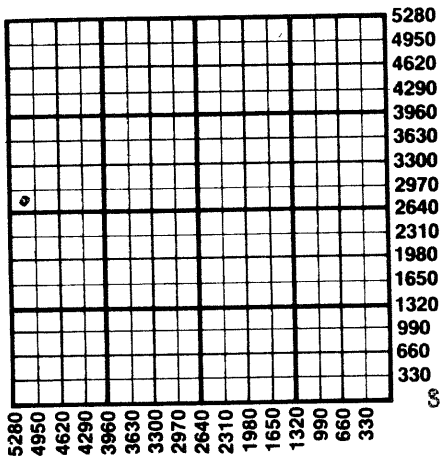

1. Notify District office before setting surface casing.
 2. Set surface casing by circulating cement to the top.
 3. File completion forms ACO-1 with K.C.C. within 90 days of well completion, following instructions on ACO-1, side 1, and including copies of wireline logs.
 4. Notify District office 48 hours prior to old well workover or re-entry.
 5. Prior to plugging, prepare a plugging plan, then obtain agreement from the appropriate district office for an approved plugging plan.
 6. Submit plugging report (CP-4) to K.C.C. after plugging is completed.
 7. Obtain an approved injection docket number before disposing of salt water.
 8. Notify K.C.C. within 10 days when injection commences or terminates.
9. If an alternate 2 completion, cement in the production pipe from below any usable water to surface within 120 days of spud date.

RECEIVED
STATE CORPORATION COMMISSION

FEB 21 1985
02-21-85
CONSERVATION DIVISION
Wichita, Kansas

State Corporation Commission of Kansas
Conservation Division
200 Colorado Derby Building
Wichita, Kansas 67202
(316) 263-3238