

CARD MUST BE TYPED

State of Kansas
NOTICE OF INTENTION TO DRILL
(see rules on reverse side)

CARD MUST BE SIGNED

Starting Date: FEB 26 85
month day year

API Number 15- 003-22,583-00-00

OPERATOR: License # 9554
OZARK RESOURCES INC.

NE 1/2 SW NW Sec 22... Twp 22. S, Rge 19. East West
(location)

Name BOX 345

3300 Ft North from Southeast Corner of Section

Address GARNETT, KS. 66032

4240 Ft West from Southeast Corner of Section

Contact Person CLYDE BOOTS

(Note: Locate well on Section Plat on reverse side)

Phone 316-852-3574

Nearest lease or unit boundary line 660 feet.

CONTRACTOR: License # 5687

County ANDERSON

Name SUN DRILLING Co. Inc.

Lease Name COOPER Well# 19

City/State PIQUA, KS 66761

Domestic well within 330 feet: yes no

Well Drilled For: Well Class: Type Equipment:

Municipal well within one mile: yes no

- Oil Swd Infield Mud Rotary
- Gas Inj Pool Ext. Air Rotary
- OWWO Expl Wildcat Cable

Depth to Bottom of fresh water 0 feet

Lowest usable water formation NONE

If OWWO: old well info as follows:

Depth to Bottom of usable water 125 feet

Operator

Surface pipe by Alternate: 1 2

Well Name

Surface pipe to be set 20 feet

Comp Date Old Total Depth

Conductor pipe if any required NONE feet

Projected Total Depth 870 feet

Ground surface elevation 1080 feet MSL

Projected Formation at TD DARK SHALE

This Authorization Expires 8-21-85

Expected Producing Formations SQUIRREL

Approved By 2-21-85

I certify that we will comply with K.S.A. 55-101, et seq., plus eventually plugging hole to K.C.C. specifications.


Date 2-18-85 Signature of Operator or Agent Clyde Boots Title Share Holder

W.H. KOONE 2-21-85

**Must be filed with the K.C.C. five (5) days prior to commencing well
This card void if drilling not started within six (6) months of date received by K.C.C.**

Important procedures to follow :

**A Regular Section of Land
1 Mile = 5,280 Ft.**

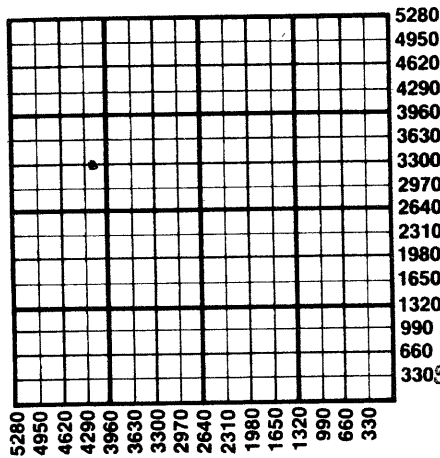

1. Notify District office before setting surface casing.
 2. Set surface casing by circulating cement to the top.
 3. File completion forms ACO-1 with K.C.C. within 90 days of well completion, following instructions on ACO-1, side 1, and including copies of wireline logs.
 4. Notify District office 48 hours prior to old well workover or re-entry.
 5. Prior to plugging, prepare a plugging plan, then obtain agreement from the appropriate district office for an approved plugging plan.
 6. Submit plugging report (CP-4) to K.C.C. after plugging is completed.
 7. Obtain an approved injection docket number before disposing of salt water.
 8. Notify K.C.C. within 10 days when injection commences or terminates.
- Alternate 2 completion, cement in the production pipe from below
through water to surface within 120 days of spud date.

RECEIVED
STATE CORPORATION COMMISSION

FEB 21 1985
02-21-85
CONSERVATION DIVISION
Wichita, Kansas

State Corporation Commission of Kansas
Conservation Division
200 Colorado Derby Building
Wichita, Kansas 67202
(316) 263-3238