

CARD MUST BE TYPED

State of Kansas

CARD MUST BE SIGNED

NOTICE OF INTENTION TO DRILL

(see rules on reverse side)

Starting Date 12 20 1985
month day year 3.50

API Number 15- 003-22,707-00-00

OPERATOR: License # 9554
Name Ozark Resources, Inc.
Address Box 345
City/State/Zip Garnett, Kansas 66032
Contact Person Clyde Boots
Phone 316 851-3574

app. NE SW SE Sec. 22 Twp. 22 S, Rg. 19 East
..... 1100 Ft. from South Line of Section
..... 1540 Ft. from East Line of Section

(Note: Locate well on Section Plat on reverse side)

CONTRACTOR: License # 6451
Name Big "E" Drilling
City/State Route 1, Centerville, KS 66014

Nearest lease or unit boundary line ... 1100 feet
County Anderson
Lease Name Cooper Well # 27E
Ground surface elevation ... 1100 feet MSL

Well Drilled For: Well Class: Type Equipment:
 Oil SWD Infield Mud Rotary
 Gas Inj Pool Ext. Air Rotary
 OWWO Expl Wildcat Cable

Domestic well within 330 feet: yes no
Municipal well within one mile: yes no
Surface pipe by Alternate: 1 2

If OWWO: old well info as follows:
Operator
Well Name
Comp Date Old Total Depth

Depth to bottom of fresh water... none 20
Depth to bottom of usable water ... 125
Surface pipe planned to be set ... 20
Projected Total Depth ... 850 feet
Formation Squirrel

I certify that well will comply with K.S.A. 55-101, et seq., plus eventually plugging hole to KCC specifications.

_____ cementing will be done immediately upon setting production casing.

REH/KOHE

Date 12/19/85 Signature of Operator or Agent *Shree Chohan* Title as agent

For KCC Use:

Conductor Pipe Required feet: Minimum Surface Pipe Required feet per Alt 1 2


This Authorization Expires 6-19-86 Approved By *R* 12-19-85

Must be filed with the K.C.C. five (5) days prior to commencing well
This card void if drilling not started within six (6) months of date received by K.C.C.

Important procedures to follow:

1. Notify District office before setting surface casing.
2. Set surface casing by circulating cement to the top.
3. File completion forms ACO-1 with K.C.C. within 90 days of well completion, following instructions on ACO-1, side 1, and including copies of wireline logs.
4. Notify District office 48 hours prior to old well workover or re-entry.
5. Prior to filing Intent, prepare a proposed plugging plan in case well is D & A, then obtain approval of plan when calling district office prior to setting surface pipe.
6. Submit plugging report (CP-4) to K.C.C. after plugging is completed.
7. Obtain an approved injection docket number before disposing of salt water.
8. Notify K.C.C. within 10 days when production commences or terminates.
9. If an alternate 2 completion, cement in the production pipe from below any usable water to surface within 120 days of spud date.

A Regular Section of Land 1 Mile = 5,280 Ft.

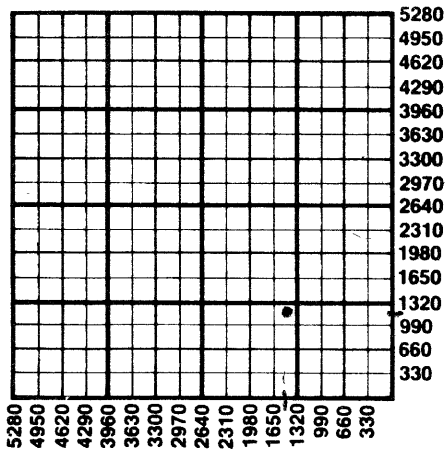

RECEIVED
STATE CORPORATION COMMISSION
12-19-85
DEC 19 1985
CONSERVATION DIVISION

State Corporation Commission of Kansas
Conservation Division
200 Colorado Derby Building
Wichita, Kansas 67202
(316) 263-3238