

CARD MUST BE TYPED

State of Kansas

CARD MUST BE SIGNED

NOTICE OF INTENTION TO DRILL

(see rules on reverse side)

Starting Date 12 month 30 day 1985 year

API Number 15- 003 - 22, 715-00-00

OPERATOR: License # 9554 app.
Name ... Ozark Resources, Inc.
Address ... Box 345
City/State/Zip ... Garnett, Kansas ... 66032
Contact Person ... Clyde Boots
Phone ... 316-851-3574

East
E/2 NE. NE. Sec. 22.. Twp. 22.. S, Rg. 19.....
4620 Ft. from South Line of Section
220 Ft. from East Line of Section

(Note: Locate well on Section Plat on reverse side)

CONTRACTOR: License # 6451
Name ... Big E Drilling
City/State ... Route 1, Centerville, KS ... 66014

Nearest lease or unit boundary line 200 feet
County Anderson
Lease Name Cooper Well # .. 28E
Ground surface elevation 1100 feet MSL
Domestic well within 330 feet: _____ yes no
Municipal well within one mile: _____ yes no
Surface pipe by Alternate: _____ 1 _____ 2 _____
Depth to bottom of fresh water 80
Depth to bottom of usable water 125
Surface pipe planned to be set 20
Projected Total Depth 850 feet
Formation Squirrel

Well Drilled For: Well Class: Type Equipment:
 Oil ___ SWD Infield Mud Rotary
___ Gas ___ Inj ___ Pool Ext. ___ Air Rotary
___ OWWO ___ Expl ___ Wildcat ___ Cable

If OWWO: old well info as follows:

Operator
Well Name
Comp Date Old Total Depth

I certify that well will comply with K.S.A. 55-101, et seq., plus eventually plugging hole to KCC specifications.

_____ cementing will be done immediately upon setting production casing.

Date ... 12/27/85 ... Signature of Operator or Agent *Sherril Chalar* Title ... as agent

For KCC Use:

Conductor Pipe Required feet; Minimum Surface Pipe Required feet per Alt. 1 2


This Authorization Expires 6-27-86 Approved By *[Signature]*

Must be filed with the K.C.C. five (5) days prior to commencing well
This card void if drilling not started within six (6) months of date received by K.C.C.

Important procedures to follow:

1. Notify District office before setting surface casing.
2. Set surface casing by circulating cement to the top.
3. File completion forms ACO-1 with K.C.C. within 90 days of well completion, following instructions on ACO-1, side 1, and including copies of wireline logs.
4. Notify District office 48 hours prior to old well workover or re-entry.
5. Prior to filing Intent, prepare a proposed plugging plan in case well is D & A, then obtain approval of plan when calling district office prior to setting surface pipe.
6. Submit plugging report (CP-4) to K.C.C. after plugging is completed.
7. Obtain an approved injection docket number before disposing of salt water.
8. Notify K.C.C. within 10 days when injection commences or terminates.
9. If an alternate 2 completion, cement in the production pipe from below any usable water to surface within 120 days of spud date.

A Regular Section of Land
1 Mile = 5,280 Ft.

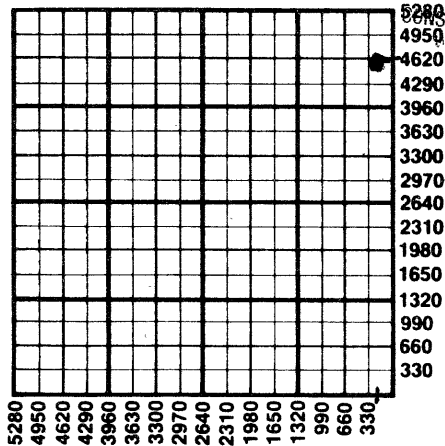

State Corporation Commission of Kansas
Conservation Division
200 Colorado Derby Building
Wichita, Kansas 67202
(316) 263-3238