

CARD MUST BE TYPED

State of Kansas

CARD MUST BE SIGNED

NOTICE OF INTENTION TO DRILL

(see rules on reverse side)

Starting Date 1 22 1986
month day year 3:50

API Number 15- 003-22,726-06-00

OPERATOR: License # 7208
Name ... Loraine Cleaver
Address ... Box 54
City/State/Zip ... Piqua, Kansas 66761
Contact Person... Loraine Cleaver
Phone ... (316) 468-2050

app. NW NW. SW... Sec. 22... Twp. 22. S, Rg. 19...
..... 2475 Ft. from South Line of Section
..... 4785 Ft. from East Line of Section

(Note: Locate well on Section Plat on reverse side)

CONTRACTOR: License # 5687
Name Sun Drilling Co., Inc.
City/State same as above

Nearest lease or unit boundary line 165 feet
County.... Anderson

Lease Name Tinsley Well # .. 2
Ground surface elevation feet MSL

Well Drilled For: Well Class: Type Equipment:
 Oil SWD Infield Mud Rotary
 Gas Inj Pool Ext. Air Rotary
 OWWO Expl Wildcat Cable

Domestic well within 330 feet: yes no
Municipal well within one mile: yes no

If OWWO: old well info as follows:
Operator
Well Name
Comp Date Old Total Depth

Depth to bottom of fresh water 45
Depth to bottom of usable water 125
Surface pipe by Alternate: 1 2
Surface pipe planned to be set 20
Conductor pipe required
Projected Total Depth 1000 feet
Formation

I certify that well will comply with K.S.A. 55-101, et seq., plus eventually plugging hole to KCC specifications.
Date 1/21/86 Signature of Operator or Agent *Shawn Cochran* Title as agent *Per/DAH*


For KCC Use:
Conductor Pipe Required feet; Minimum Surface Pipe Required 20 feet per Alt. (2)
This Authorization Expires 7-21-86 Approved By *Rc* 1-21-86

Must be filed with the K.C.C. five (5) days prior to commencing well
This card void if drilling not started within six (6) months of date received by K.C.C.

Important procedures to follow:

A Regular Section of Land
1 Mile = 5,280 Ft.

RECEIVED
STATE CORPORATION COMMISSION
01-21-86
JAN 21 1986
CONSERVATION DIVISION
Wichita, Kansas

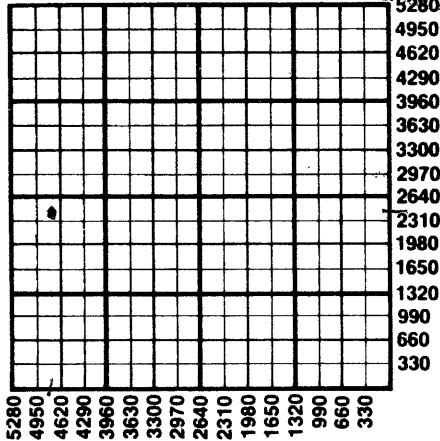

1. Notify District office before setting surface casing.
2. Set surface casing by circulating cement to the top.
3. File completion forms ACO-1 with K.C.C. within 90 days of well completion, following instructions on ACO-1, side 1, and including copies of wireline logs.
4. Notify District office 48 hours prior to old well workover or re-entry.
5. Prior to filing Intent, prepare a proposed plugging plan in case well is D & A, then obtain approval of plan when calling district office prior to setting surface pipe.
6. Submit plugging report (CP-4) to K.C.C. after plugging is completed.
7. Obtain an approved injection docket number before disposing of salt water.
8. Notify K.C.C. within 10 days when injection commences or terminates.
9. If an alternate 2 completion, cement in the production pipe from below any usable water to surface within 120 days of spud date.

State Corporation Commission of Kansas
Conservation Division
200 Colorado Derby Building
Wichita, Kansas 67202
(316) 263-3238