

CARD MUST BE TYPED

State of Kansas

CARD MUST BE SIGNED

NOTICE OF INTENTION TO DRILL

(see rules on reverse side)

Starting Date 12 month 31 day 1986 year 354

API Number 15- 003-22771-00-00 X East

OPERATOR: License # 9554

App. .SE SE SE Sec...22 Twp.22... S, Rg....19. ~~XXXX~~

Name Ozark Resources Inc

Address Box 345

City/State/Zip Garnett, KS 66032

Contact Person.... Steve Doering

Phone..... 913.448.5493

..... 520..... Ft. from South Line of Section
..... 220..... Ft. from East Line of Section

(Note: Locate well on Section Plat on reverse side)

Nearest lease or unit boundary line 220..... feet

County..... Anderson

Lease Name.... Cooper Well # 32

Ground surface elevation 1100..... feet MSL

Domestic well within 330 feet: _____ yes no

Municipal well within one mile: _____ yes no

Depth to bottom of fresh water..... 20.....

Depth to bottom of usable water 125.....

Surface pipe by Alternate: _____ 1 _____ 2

Surface pipe planned to be set 20.....

Conductor pipe required

Projected Total Depth 850..... feet

Formation..... Squirrel

CONTRACTOR: License # 6451

Name Big E Drilling

City/State Route 1, Centerville, KS 66014

Well Drilled For: Well Class: Type Equipment:

Oil _____ SWD Infield _____ Mud Rotary

_____ Gas _____ Inj _____ Pool Ext. Air Rotary

_____ OWWO _____ Expl _____ Wildcat _____ Cable

If OWWO: old well info as follows:

Operator

Well Name

Comp Date Old Total Depth.....

I certify that well will comply with K.S.A. 55-101, et seq., plus eventually plugging hole to KCC specifications.

Date ... 12/29/86 ... Signature of Operator or Agent *Elaine Burkum* Title as agent

For KCC Use:

Conductor Pipe Required feet; Minimum Surface Pipe Required 20 feet per Alt. *20*

This Authorization Expires 6-29-87 Approved By 12-29-86 *[Signature]*


[Signature]

Must be filed with the K.C.C. five (5) days prior to commencing well
 This card void if drilling not started within six (6) months of date received by K.C.C.

Important procedures to follow:

1. Notify District office before setting surface casing.
2. Set surface casing by circulating cement to the top.
3. File completion forms ACO-1 with K.C.C. within 90 days of well completion, following instructions on ACO-1, side 1, and including copies of wireline logs.
4. Notify District office 48 hours prior to old well workover or re-entry.
5. Prior to filing Intent, prepare a proposed plugging plan in case well is D & A, then obtain approval of plan when calling district office prior to setting surface pipe.
6. Submit plugging report (CP-4) to K.C.C. after plugging is completed.
7. Obtain an approved injection docket number before disposing of salt water.
8. Notify K.C.C. within 10 days when injection commences or terminates.

A Regular Section of Land
1 Mile = 5,280 Ft.

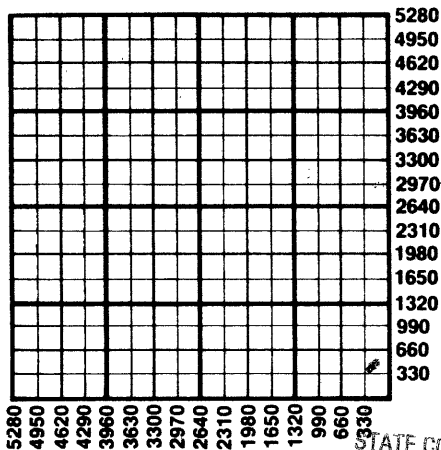

RECEIVED
 STATE CORPORATION COMMISSION

DEC 29 1986
 12-29-86
 CONSERVATION DIVISION
 Wichita, Kansas

9. If an alternate 2 completion, cement in the production pipe from below any usable water to surface within 120 days of spud date.

State Corporation Commission of Kansas
 Conservation Division
 200 Colorado Derby Building
 Wichita, Kansas 67202
 (316) 263-3238