

CARD MUST BE TYPED

State of Kansas

CARD MUST BE SIGNED

NOTICE OF INTENTION TO DRILL

(see rules on reverse side)

Starting Date 3 10 1987
month day year

API Number 15— 003-22,778-00-00

OPERATOR: License # 9554

SE SE SE Sec. 22 Twp. 22 S, Rg. 19 ^X East

Name OZARK RESOURCES, INC.

165 Ft. from South Line of Section

Address Box 345

220 Ft. from East Line of Section

City/State/Zip Garnett, Kansas 66032

(Note: Locate well on Section Plat on reverse side)

Contact Person Brad Cook

Nearest lease or unit boundary line 165 feet

Phone (316) 852-3333

County ANDERSON

CONTRACTOR: License # 6451

Lease Name COOPER Well # 33

Name Big "E" Drlg.

Ground surface elevation feet MSL

City/State Centerville, Kans.

Domestic well within 330 feet: _____ yes ^X no

Well Drilled For: Well Class: Type Equipment:

Municipal well within one mile: _____ yes ^X no

Oil _____ SWD Infield _____ Mud Rotary

Depth to bottom of fresh water 0

_____ Gas _____ Inj _____ Pool Ext. Air Rotary

Depth to bottom of usable water 125

_____ OWWO _____ Expl _____ Wildcat _____ Cable

Surface pipe by Alternate: 1 _____ 2 ^X _____

If OWWO: old well info as follows:

Surface pipe planned to be set 20

Operator

Conductor pipe required None

Well Name

Projected Total Depth 825 feet

Comp Date Old Total Depth

Formation Squirrel

I certify that well will comply with K.S.A. 55-101, et seq., plus eventually plugging hole to KCC specifications.

Date ... 3-9-87 Signature of Operator or Agent *Frank ...* Title Agent

For KCC Use:

Conductor Pipe Required feet; Minimum Surface Pipe Required 20 feet per Alt. *810*

This Authorization Expires 9-10-87 Approved By 3-10-87 *PAK*

Must be filed with the K.C.C. five (5) days prior to commencing well
This card void if drilling not started within six (6) months of date received by K.C.C.


RECEIVED
STATE CORPORATION COMMISSION

03-10-87
MAR 10 1987

Important procedures to follow:

A Regular Section of Land
1 Mile = 5,280 Ft.

CONSERVATION DIVISION
Wichita, Kansas

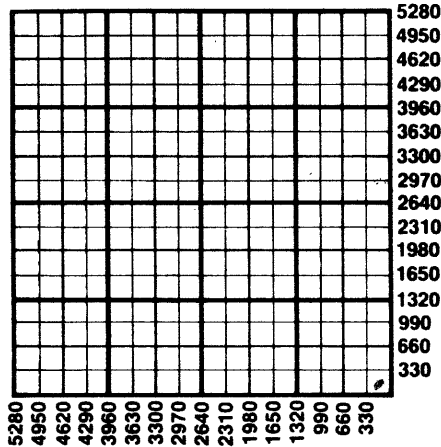

1. Notify District office before setting surface casing.
2. Set surface casing by circulating cement to the top.
3. File completion forms ACO-1 with K.C.C. within 90 days of well completion, following instructions on ACO-1, side 1, and including copies of wireline logs.
4. Notify District office 48 hours prior to old well workover or re-entry.
5. Prior to filing Intent, prepare a proposed plugging plan in case well is D & A, then obtain approval of plan when calling district office prior to setting surface pipe.
6. Submit plugging report (CP-4) to K.C.C. after plugging is completed.
7. Obtain an approved injection docket number before disposing of salt water.
8. Notify K.C.C. within 10 days when injection commences or terminates.
9. If an alternate 2 completion, cement in the production pipe from below any usable water to surface within 120 days of spud date.

State Corporation Commission of Kansas
Conservation Division
200 Colorado Derby Building
Wichita, Kansas 67202
(316) 263-3238