

CARD MUST BE TYPED

State of Kansas

CARD MUST BE SIGNED

NOTICE OF INTENTION TO DRILL

(see rules on reverse side)

Starting Date JAN, 21, 1986
month day year

API Number 15— 003-22, 720-00-00
NW NE SW * East

OPERATOR: License # ... 9554
Name QZARK RESOURCES INC.
Address BOX 345
City/State/Zip ... GARNETT, KS. 66032
Contact Person ... CLYDE BOOTS
Phone 316 852 3574

Sec. 23.. Twp. 22.. S, Rg. 19...
2420 Ft. from South Line of Section
3740 Ft. from East Line of Section

(Note: Locate well on Section Plat on reverse side)

CONTRACTOR: License #
Name CONTRACTOR UNKNOWN
City/State

Nearest lease or unit boundary line 220 feet
County anderson

Lease Name .. MILLER Well # .. 1
Ground surface elevation 1100 feet MSL

Well Drilled For:	Well Class:	Type Equipment:
* Oil ___ SWD	* Infield	___ Mud Rotary
___ Gas ___ Inj	___ Pool Ext.	* Air Rotary
___ OWWO ___ Expl	___ Wildcat	___ Cable

Domestic well within 330 feet: ___ yes * ___ no
Municipal well within one mile: ___ yes * ___ no

Surface pipe by Alternate: 1 2 *

If OWWO: old well info as follows:

Operator
Well Name
Comp Date Old Total Depth

Depth to bottom of fresh water 0

Depth to bottom of usable water 125

Surface pipe planned to be set 20

Projected Total Depth 850 feet

Formation SQUIRREL

I certify that well will comply with K.S.A. 55-101, et seq., plus eventually plugging hole to KCC specifications.

cementing will be done immediately upon setting production casing.

Date 1-14-86 Signature of Operator or Agent *Clyde Boots* Title *Shareholder* *RCM/KOH*

For KCC Use:

Conductor Pipe Required feet; Minimum Surface Pipe Required 20 feet per Alg X 2


This Authorization Expires 7-17-86 Approved By 1-17-86

Must be filed with the K.C.C. five (5) days prior to commencing well
This card void if drilling not started within six (6) months of date received by K.C.C.

Important procedures to follow:

1. Notify District office before setting surface casing.
2. Set surface casing by circulating cement to the top.
3. File completion forms ACO-1 with K.C.C. within 90 days of well completion, following instructions on ACO-1, side 1, and including copies of wireline logs.
4. Notify District office 48 hours prior to old well workover or re-entry.
5. Prior to filing Intent, prepare a proposed plugging plan in case well is D & A, then obtain approval of plan when calling district office prior to setting surface pipe.
6. Submit plugging report (CP-4) to K.C.C. after plugging is completed.
7. Obtain an approved injection docket number before disposing of salt water.
8. Notify K.C.C. within 10 days when injection commences or terminates.
9. If an alternate 2 completion, cement in the production pipe from below any usable water to surface within 120 days of spud date.

**A Regular Section of Land
1 Mile = 5,280 Ft.**

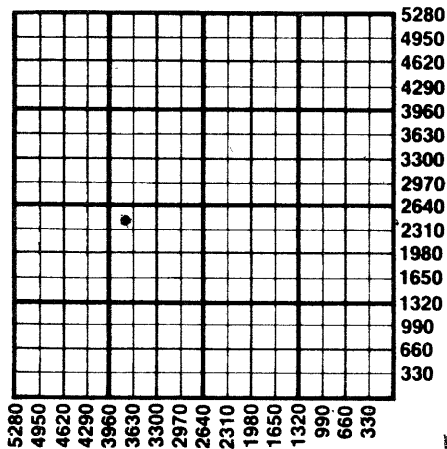

RECEIVED
STATE CORPORATION COMMISSION

JAN 17 1986
01-17-86
CONSERVATION DIVISION

State Corporation Commission of Kansas
Conservation Division
200 Colorado Derby Building
Wichita, Kansas 67202
(316) 263-3238