

KANSAS CORPORATION COMMISSION
OIL & GAS CONSERVATION DIVISION

Form CP-1
September 2003
Form must be Typed
Form must be Signed
All blanks must be Filled

WELL PLUGGING APPLICATION

Please TYPE Form and File ONE Copy

API # 15-15-129-00503-00-00 (Identifier Number of this well). This must be listed for wells drilled since 1967; if no API # was issued.

Indicate original spud or completion date S11-18-51 C11-23-51

Well Operator: BP AMERICA PRODUCTION COMPANY KCC License #: 5952

Address: P. O. BOX 3092, WL1 RM 11.141 City: HOUSTON
(Owner/Company Name) (Operator's)

State: TEXAS Zip Code: 77253-3092 Contact Phone: 281 366-4395

Lease: Sparks Gas Unit Well #: 1 Sec. 9 Twp. 31 S R. 39 W East West

NE - NE - NE - SW Spot Location/QQQQ County MORTON

2640 Feet from (in exact footage) North / South (from nearest outside section corner) Line of Section (not Lease Line)

2640 Feet from (in exact footage) East / West (from nearest outside section corner) Line of Section (not Lease Line)

Check One: Oil Well Gas Well D&A Cathodic Water Supply Well
 SWD Docket # _____ ENHR Docket # _____ Other _____

Conductor Casing Size: _____ Set at: _____ Cemented with: _____ Sacks

Surface Casing Size: 10 - 3/4" Set at: 639' Cemented with: 450 Sacks

Production Casing Size: 7 " Set at: 2558' Cemented with: 300 Sacks

List (ALL) Perforations and Bridgeplug Sets: 2392-2546' CTBP SET AT 2290'

Elevation: 3185' (G.L. K.B.) T.D. 2681' PBTD _____ Anhydrite Depth _____
(Stone Corral Formation)

Condition of Well: Good Poor Casing Leak Junk in Hole

Proposed Method of Plugging (attach a separate page if additional space is needed): SEE ATTACHED PROCEDURES.

Is Well Log attached to this application as required? Yes No Is ACO-1 filed? Yes No

If not explain why? _____

Plugging of this Well will be done in accordance with K.S.A. 55-101 et. seq. and the Rules and Regulations of the State Corporation Commission

List Name of Company Representative authorized to be in charge of plugging operations:

DEANN SMYERS Phone: 281 366-4395

Address: P. O. BOX 3092, WL 1, RM 11.141 City/State HOUSTON, TEXAS 77253-3092

Plugging Contractor HALLIBURTON SERVICES KCC License # 5287
(Company Name) (Contractor's)

Address _____ Phone: _____

Proposed Date and Hour of Plugging (if known?): _____

Payment of the Plugging Fee (K.A.R. 82-3-118) will be guaranteed by Operator or Agent

Date: SEPT. 20, 2006 Authorized Operator / Agent: DeAnn Smyers (Signature)

Mail to: KCC - Conservation Division, 130 S. Market - Room 2078, Wichita, Kansas 67202

RECEIVED
OC 10-2-06
KCC WICHITA

Plugging Application
Sparks 1 - Abandonment
Sec 9, T31S, R39W
Morton County, Kansas

The application attached is to abandon the Sparks 1. BP Amoco is abandoning this well as it has become uneconomic to operate.

RECEIVED
OCT - 2 200
KCC WICHIT

**Plugging Procedure for the Sparks 1
Section 9 T31S R39W
Morton County, Kansas**

NOTE – NOTIFY KCC DISTRICT OFFICE AT LEAST FIVE DAYS IN ADVANCE OF WORK.


This procedure was approved via a telephone conversation between Joe Eudey (BP representative) and Eric Maclaren (KCC) on September 9, 2006.

PROPOSED PROCEDURE:

1. Set CIBP in 4.5" liner at 2290'. Dump 2 sacks of cement on top of plug with dump bailer. **(This step was completed on 9-6-2006 to stop water cross flow)**
2. Set CIBP at 700'.
3. Perforate circulating holes at 650'
4. Mix and pump 207 sacks of cement down 4.5" casing, through holes at 650', and up 7" X 10.75" annulus, leaving the annulus and the 4.5" casing full of cement. Cement blend to be 60/40 class C premium plus with 6% gel, mixed at 13.1 ppg, yield 1.53 cuft/sk.
5. Cut off and cap casing 4' below ground level.
6. Restore the location.

**RECEIVED
OCT - 2 2006
KCC WICHITA**


Sparks 1
Section 9, T31S, R39W
Chase Formation
Hugoton Field
Morton County, Kansas

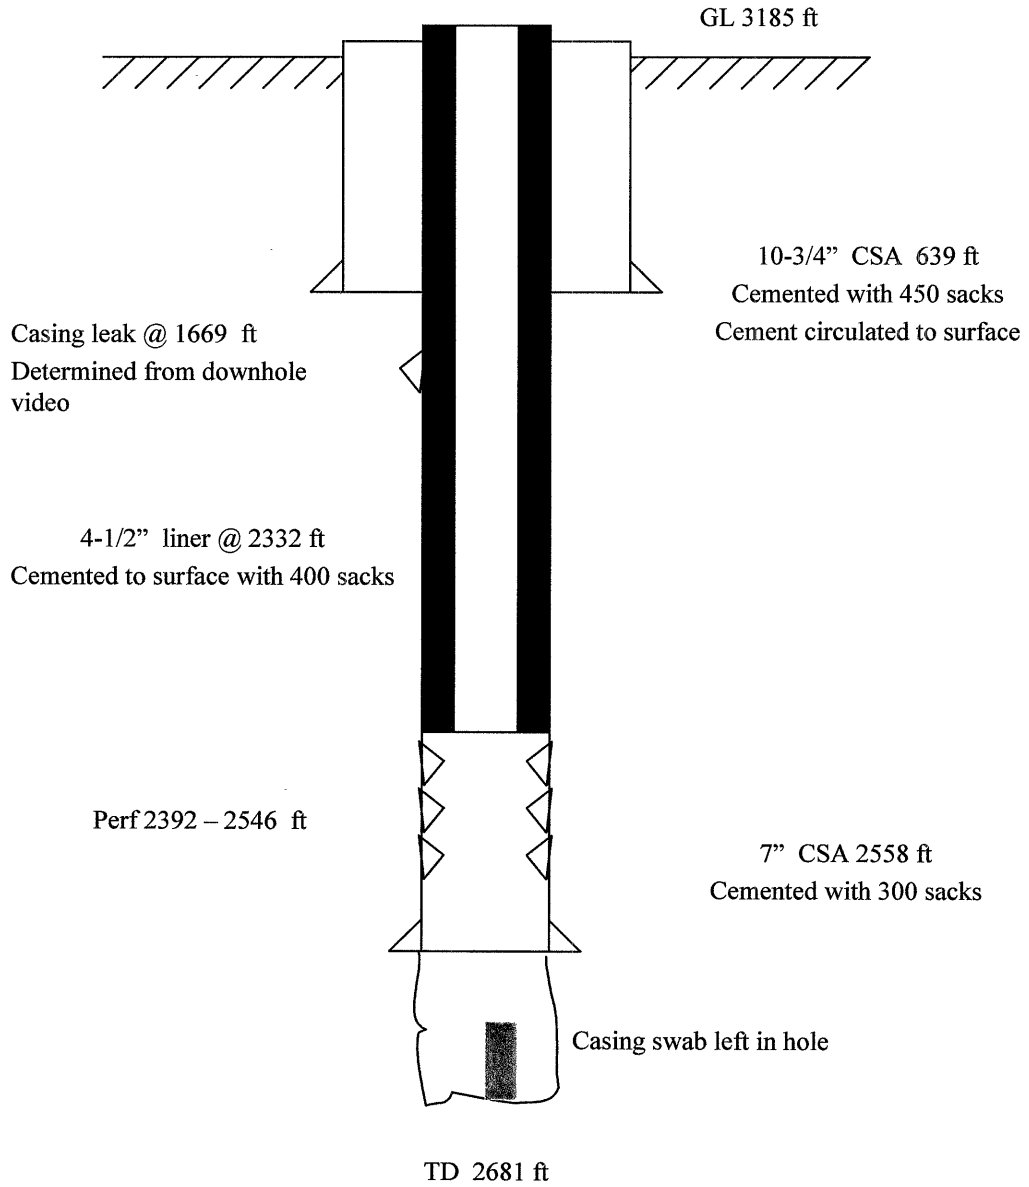

Not to scale

RECEIVED
OCT - 2 2006
KCC WICHITA

Sparks 1
Section 9, T31S, R39W
Chase Formation
Hugoton Field
Morton County, Kansas

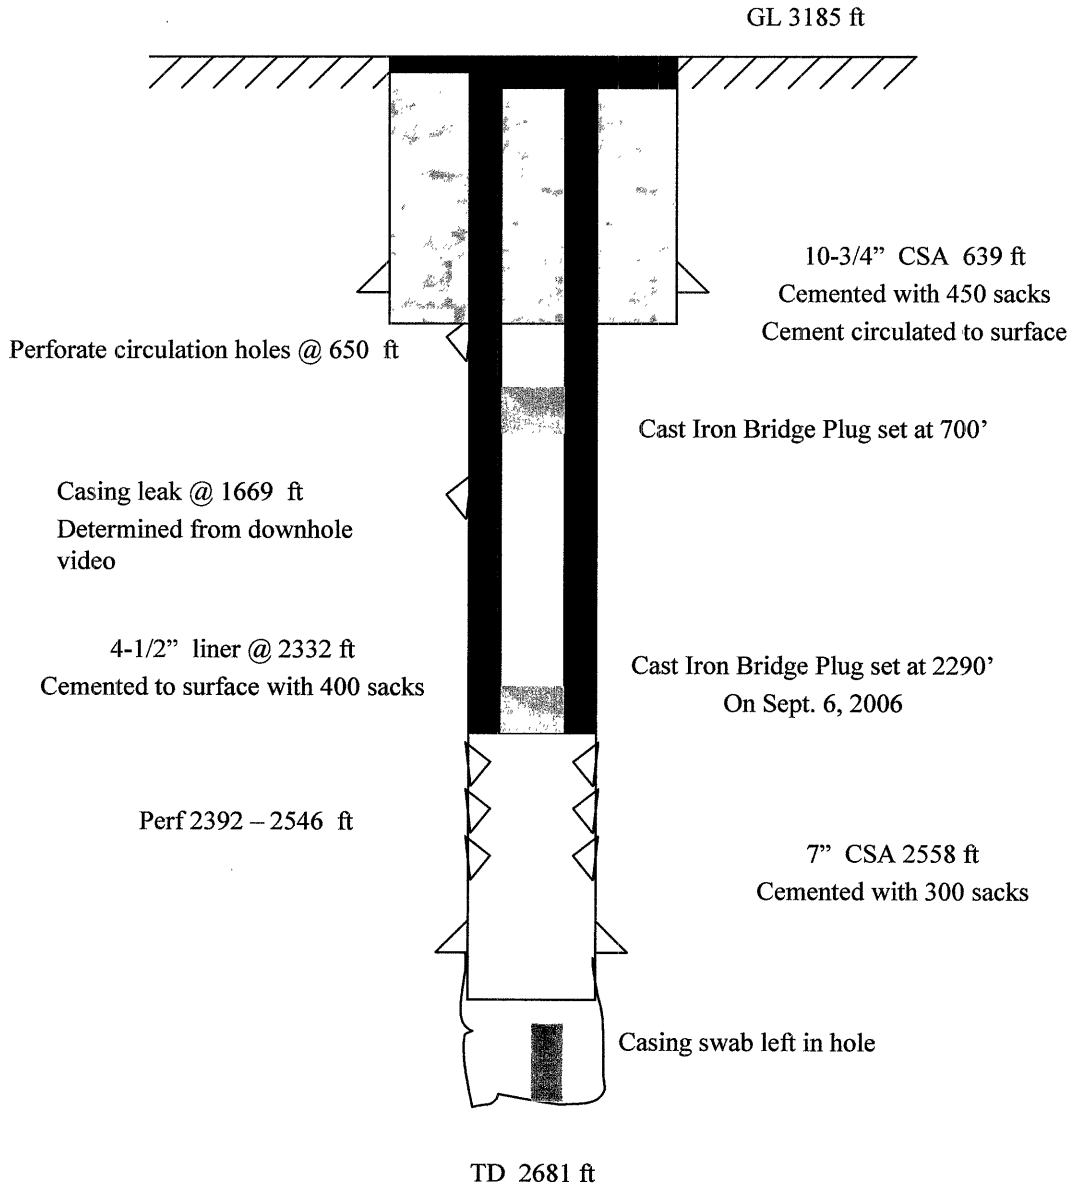

Not to scale

RECEIVED
OCT - 27
KCC WICHITA

KANSAS

CORPORATION COMMISSION

Kathleen Sebelius, Governor Brian J. Moline, Chair Robert E. Krehbiel, Commissioner Michael C. Moffet, Commissioner

NOTICE OF RECEIPT OF WELL PLUGGING APPLICATION (CP-1)

BP America Production Company
2225 West Oklahoma Avenue
Ulysses, KS 67880

October 10, 2006

Re: SPARKS GU #1
API 15-129-00503-00-00
NENENESW 9-31S-39W, 2640 FNL 2640 FWL
MORTON COUNTY, KANSAS

Dear Operator:

This letter is to notify you that the Conservation Division is in receipt of your plugging proposal, form CP-1, for the above-captioned well.


Your CP-1 has been reviewed by the Conservation Division central office for completeness and to verify license numbers. The plugging proposal will now be forwarded to the district office listed below for review of your proposed method of plugging.

Please contact the district office for approval of your proposed plugging method at least five (5) days before plugging the well, pursuant to K.A.R. 82-3-113 (b). If a workover pit will be used during the plugging of the well it must be permitted. A CDP-1 form must be filed and approved prior to the use of the pit.

The Conservation Division's review of form CP-1, either in the central or district office, does not include an inquiry into well ownership or the filing operator's legal right to plug the well.

This notice in no way constitutes authorization to plug the above-captioned well by persons not having legal rights of ownership or interest in the well. This notice is void after ninety (90) days from the above date.

Sincerely

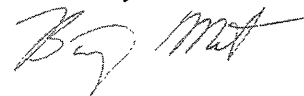

Barry Metz
Deputy Director

District: #1
210 E Frontview, Suite A
Dodge City, KS 67801
(620) 225-8888