

KANSAS CORPORATION COMMISSION
OIL & GAS CONSERVATION DIVISION
WELL PLUGGING APPLICATION
Please TYPE Form and File ONE Copy

Form CP-1
September 2003
This Form must be Typed
Form must be Signed
All blanks must be Filled

API # 15 - 095-22044 -00-00 (Identifier Number of this well). This must be listed for wells drilled since 1967; if no API # was issued,

indicate original spud or completion date 7-18-06

Well Operator: Pickrell Drilling Company, Inc. KCC License #: 5123
(Owner / Company Name) (Operator's)

Address: 100 S. Main, Suite 505 City: Wichita

State: Kansas Zip Code: 67202 Contact Phone: (316) 262 - 8427

Lease: Reida Well #: 5 Sec. 1 Twp. 30S S. R. 7 East West

- SW - NW - SW Spot Location / QQQQ County: Kingman

1650 Feet (in exact footage) From North / South (from nearest outside section corner) Line of Section (Not Lease Line)

330 Feet (in exact footage) From East / West (from nearest outside section corner) Line of Section (Not Lease Line)

Check One: Oil Well Gas Well D&A Cathodic Water Supply Well
 SWD Docket # _____ ENHR Docket # _____ Other: _____

Conductor Casing Size: _____ Set at: _____ Cemented with: _____ Sacks

Surface Casing Size: 8 5/8 Set at: 261 Cemented with: 200 Sacks

Production Casing Size: 4 1/2" Set at: 4198 Cemented with: 160 Sacks

List (ALL) Perforations and Bridgeplug Sets: Perfs. 4096-4106

Elevation: 1459 (G.L. / K.B.) T.D.: 4202 PBDT: 4160 ~~Anhydrite~~ Depth: Heebneer Sh 3057 (-1598)
(Stone Corral Formation)

Condition of Well: Good Poor Casing Leak Junk in Hole

Proposed Method of Plugging (attach a separate page if additional space is needed): Plug back with sand to 4050. Use dump bailer to dump 5 sx. cement on top of sand. Cut and recover casing. After casing recovery follow top hole plugging instructions of K.C.C. District 2 office (316-630-4000).

Is Well Log attached to this application as required? Yes No Is ACO-1 filed? Yes No

If not explain why? _____

RECEIVED
KANSAS CORPORATION COMMISSION
SEP 29 2006

CONSERVATION DIVISION
WICHITA, KS

Plugging of this Well will be done in accordance with K.S.A. 55-101 et. seq. and the Rules and Regulations of the State Corporation Commission.

List Name of Company Representative authorized to be in charge of plugging operations: Russell Myers

Phone: (620) 793 - 2316

Address: 2485 S. State Rd. 14 City / State: Kingman, Kansas 67068-8629

Plugging Contractor: Quality Well Service KCC License #: 31925

Address: 401 West Main, Lyons, Kansas 67554 Phone: (620) 727 - 3470 (or 3409 cell)
(Company Name) (Contractor's)

Proposed Date and Hour of Plugging (if known?): October 3, 2006

Payment of the Plugging Fee (K.A.R. 82-3-118) will be guaranteed by Operator or Agent

Date: 09-29-06 Authorized Operator / Agent: _____
(Signature)

Mail to: KCC - Conservation Division, 130 S. Market - Room 2078, Wichita, Kansas 67202


BAKER SERVICE TOOLS - TALLY PAD

New Completion Workover

Oil Company _____ Well No. 5 Field Spivy Lease Reida
Company Man _____ Date Drilled 6/06 County Kingman State Kansas

SW NW SW Sec 1-30S-7W

API# 15-09S-22044

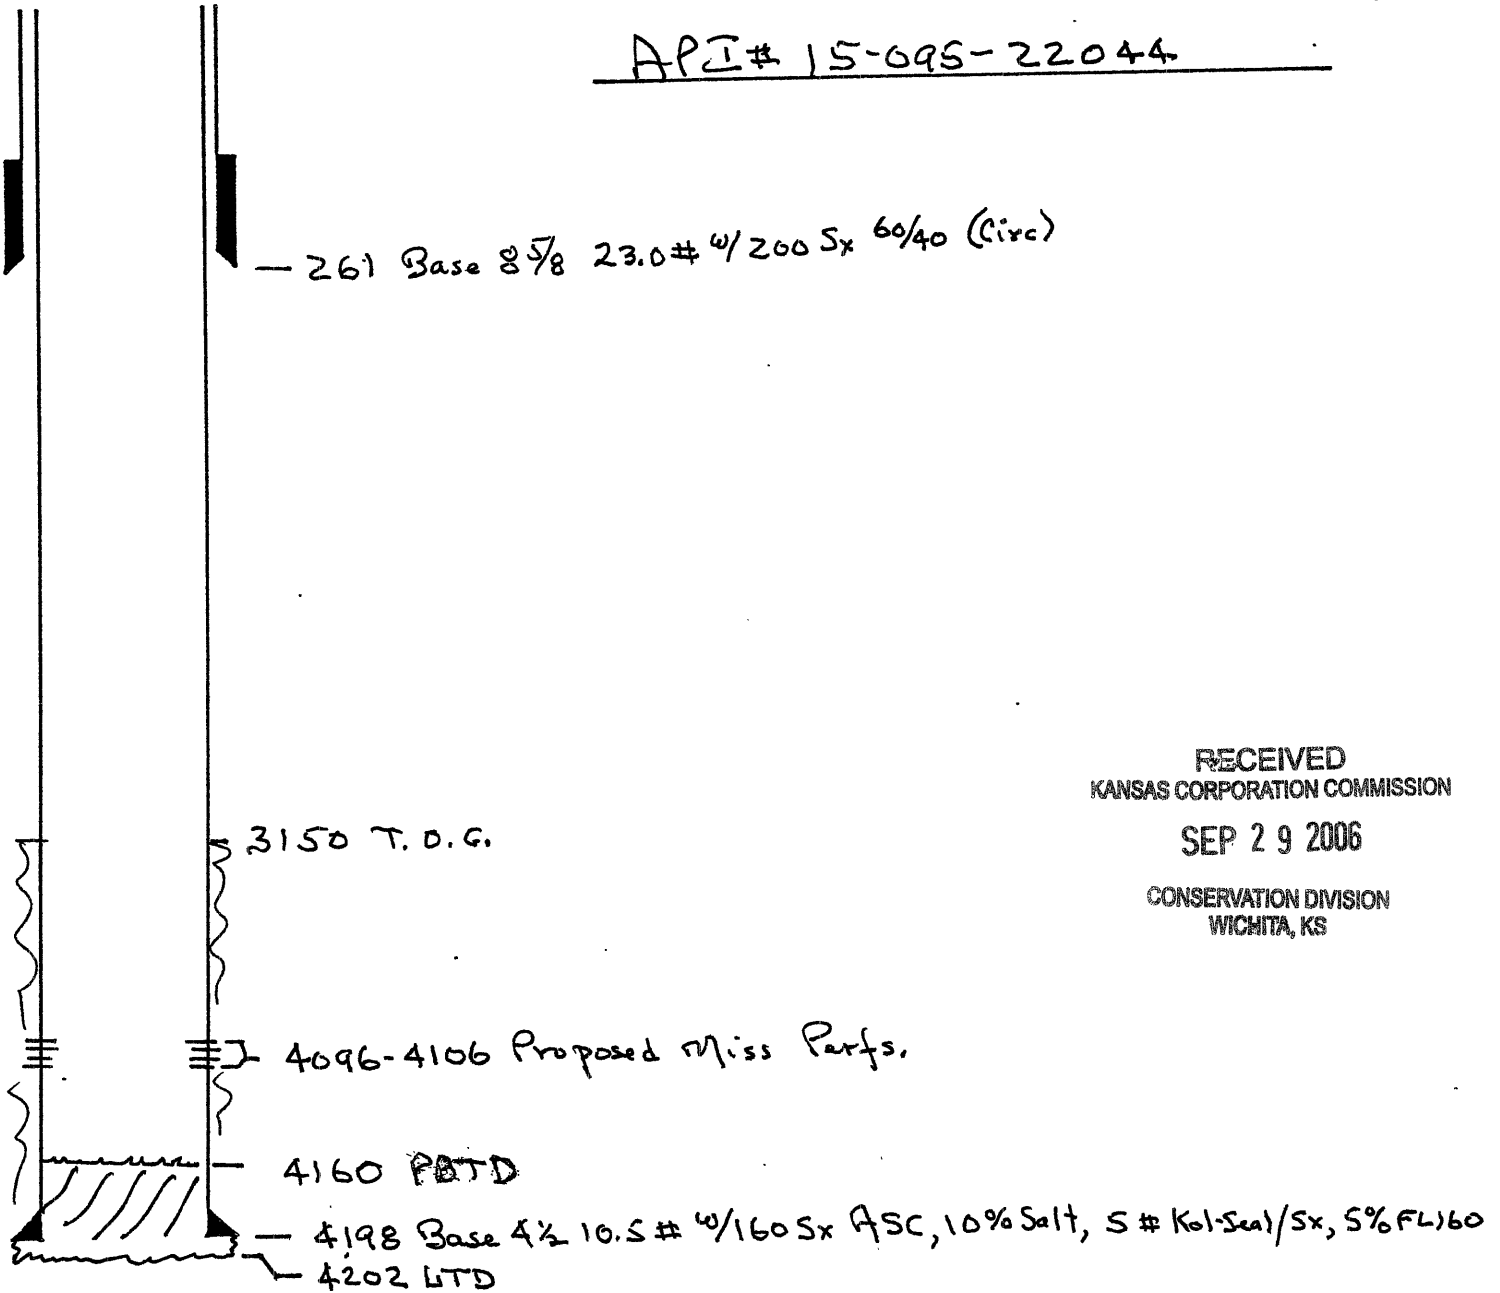

RECEIVED
KANSAS CORPORATION COMMISSION
SEP 29 2006
CONSERVATION DIVISION
WICHITA, KS

PICKRELL DRILLING COMPANY, INC.

100 SOUTH MAIN - SUITE 505
WICHITA, KANSAS 67202-3738
(316) 262-8427 • FAX (316) 262-0893

September 29, 2006

RECEIVED
KANSAS CORPORATION COMMISSION

SEP 29 2006

CONSERVATION DIVISION
WICHITA, KS

Kansas Corporation Commission
Conservation Division
130 S. Market, Room 2078
Wichita, Kansas 67202


Well Plugging Application Form CP-1
Reida No. 5
Sec. 1-30S-7W, Kingman Cty., Kansas
(API #15-095-22044)

Gentlemen:

Enclosed please find a Well Plugging Application for the captioned well. We have a rig lined up which would be able to do this work the first part of the coming week. We would like to take advantage of this often scarce equipment while it is available. We currently have the work scheduled to begin next Tuesday, October 3rd.

Yours very truly,

PICKRELL DRILLING COMPANY, INC.

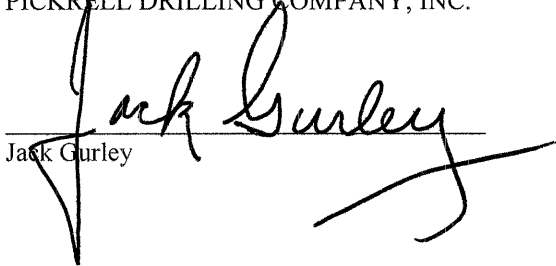
Jack Gurley

cc: Russell Myers

Kansas Corporation Commission District #2
3450 N. Rock Rd., Suite 601
Wichita, KS 67226

Quality Well Service
401 West Main
Lyons, KS 67554

KANSAS

CORPORATION COMMISSION

Kathleen Sebelius, Governor Brian J. Moline, Chair Robert E. Krehbiel, Commissioner Michael C. Moffet, Commissioner

NOTICE OF RECEIPT OF WELL PLUGGING APPLICATION (CP-1)

Pickrell Drilling Company, Inc.
100 South Main - Suite 505
Wichita, KS 67202-3738

October 09, 2006

Re: REIDA #5
API 15-095-22044-00-00
SWNWSW 1-30S-7W, 1650 FSL 330 FWL
KINGMAN COUNTY, KANSAS

Dear Operator:

This letter is to notify you that the Conservation Division is in receipt of your plugging proposal, form CP-1, for the above-captioned well.


Your CP-1 has been reviewed by the Conservation Division central office for completeness and to verify license numbers. The plugging proposal will now be forwarded to the district office listed below for review of your proposed method of plugging.

Please contact the district office for approval of your proposed plugging method at least five (5) days before plugging the well, pursuant to K.A.R. 82-3-113 (b). If a workover pit will be used during the plugging of the well it must be permitted. A CDP-1 form must be filed and approved prior to the use of the pit.

The Conservation Division's review of form CP-1, either in the central or district office, does not include an inquiry into well ownership or the filing operator's legal right to plug the well.

This notice in no way constitutes authorization to plug the above-captioned well by persons not having legal rights of ownership or interest in the well. This notice is void after ninety (90) days from the above date.

Sincerely

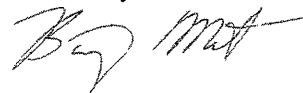

Barry Metz
Deputy Director

District: #2
3450 N. Rock Road, Suite 601
Wichita, KS 67226
(316) 630-4000