


STATE OF KANSAS
STATE CORPORATION COMMISSION

WELL PLUGGING RECORD

Give All Information Completely
Make Required Affidavit
Mail or Deliver Report to
Conservation Division
State Corporation Comm.
245 North Water
Wichita, KS 67202

Osborne County, Sec. 14 Twp. 10S Rge. 12W E/W
Location as "NE/CNW 1/4 SW 1/4" or footage from lines
NE/4 NE/4 NE/4

Lease Owner Terra Resources, Inc.
Lease Name Robinson Well No. 1
Office Address P. O. Box 839, Oklahoma City, Oklahoma 73101
Character of Well (Completed as Oil, Gas or Dry Hole) D & A

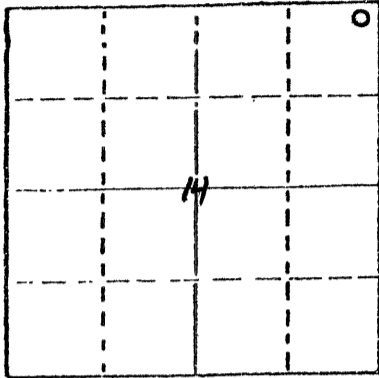

Locate well correctly on above
Section Plat

Date Well completed November 3, 1978
Application for plugging filed November 3, 1978
Application for plugging approved November 3, 1978
Plugging commenced November 3, 1978
Plugging completed November 3, 1978
Reason for abandonment of well or producing formation D & A

If a producing well is abandoned, date of last production 19

Was permission obtained from the Conservation Division or its agents before plugging was commenced? Yes

Name of Conservation Agent who supervised plugging of this well Duane L. Rankin
Producing formation Depth to top Bottom Total Depth of Well 4,045'
Show depth and thickness of all water, oil and gas formations.

OIL, GAS OR WATER RECORDS

CASING RECORD

FORMATION	CONTENT	FROM	TO	SIZE	PUT IN	PULLED OUT
				8 5/8"	464.05'	-0-

Describe in detail the manner in which the well was plugged, indicating where the mud fluid was placed and the method or methods used in introducing it into the hold. If cement or other plugs were used, state the character of same and depth placed, from feet to feet for each plug set.

Hole plugged w/50 sx cement @ 480'
1/2 sx hulls & plug @ 40' w/10 sx cement to surface
2 sx cement in rathole
(Cement - 50/50 Pozmix, 4% Gel)

RECEIVED
STATE CORPORATION COMMISSION

NOV 20 1978

11-20-78

(If additional description is necessary, use BACK of this sheet)
Name of Plugging Contractor Red Tiger Drilling Company & Allied Cementing


STATE OF Kansas COUNTY OF Sedgwick, ss. contractor
Gloria Fawcett (employee of ~~xxxxxx~~)
of the above-described well, being first duly sworn on oath, says: That I have knowledge of the facts, statements, and matters herein contained and the log of the above-described well as filed and that the same are true and correct. So help me God.

(Signature) Gloria Fawcett
1720 KSB&T Building, Wichita, Kansas 67202
(Address)

SUBSCRIBED AND SWORN TO before me this 7th day of November, 1978.

My commission expires

Joyce A. Hagermann
Notary Public.

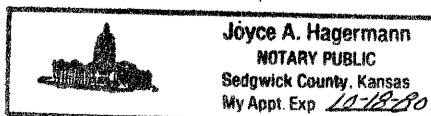

DRILLERS LOG

NO. 1 ROBINSON

CASING RECORD:
8 5/8" @ 472'
w/300 sx cement

COMPANY: Terra Resources, Inc.
CONTRACTOR: Red Tiger Drilling Company
COMMENCED: October 18, 1978
COMPLETED: November 3, 1978

DESCRIPTION:
NE/4 NE/4 NE/4
Sec. 14-T10S-R12W
Osborne County, Kansas

TOTAL DEPTH: 4,045'

ELEVATION: 1,702' KB

<u>FORMATION</u>	<u>FROM</u>	<u>TO</u>	<u>REMARKS</u>
Surface Soil, Rock & Shale	0	157	
Shale & Sand	157	250	
Shale	250	685	
Red Bed	685	720	
Anhydrite	720	753	
Shale	753	1402	
Shale & Lime	1402	1760	
Lime & Shale	1760	2653	
Lime	2653	3560	
Chert - Lime	3560	3600	
Lime	3600	4045	
RTD		4045	


I certify that this is a true and correct copy of the above log to the best of my knowledge.

RED TIGER DRILLING COMPANY

Gloria Fawcett
Gloria Fawcett

Subscribed and sworn to before me this 7th day of November, 1978.

Joyce A. Hagermann
Notary Public

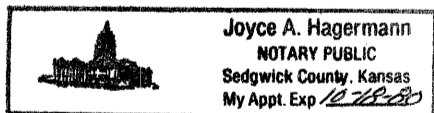

RECEIVED
STATE CORPORATION COMMISSION

NOV 20 1978

CONSERVATION DIVISION
Wichita, Kansas