

FOR KCC USE:

FORM C-1 7/91

EFFECTIVE DATE: 11-13-95

FORM MUST BE TYPED

DISTRICT # 4

State of Kansas
NOTICE OF INTENTION TO DRILL

FORM MUST BE SIGNED

ISAT... Yes... No

Must be approved by the K.C.C. five (5) days prior to commencing well

ALL BLANKS MUST BE FILLED

Expected Spud Date 11 27 1995
month day year

Spot _____ East
S.W.-S.W...-NW... Sec .1.0. Twp 1.0.. S. Rg 1.2. X West

OPERATOR: License # 3956
Name: Brungardt Oil and Leasing Co
Address: PO Box 871
City/State/Zip: Russell, Kansas 67665
Contact Person: Gary L. Brungardt
Phone: 913-483-4975

2970 feet from South / North line of Section
330 feet from East / West line of Section
IS SECTION X REGULAR _____ IRREGULAR

(NOTE: Locate well on the Section Plat on Reverse Side)

County: Osborne

Lease Name: Sigle, B. Well #: 1

Field Name: Sigle

Is this a Prorated/Spaced Field? yes X.. no

Target Formation(s): Lansing-KC

Nearest lease or unit boundary: 330

Ground Surface Elevation: 1765 feet MSL

Water well within one-quarter mile: yes X.. no

Public water supply well within one mile: yes X.. no

Depth to bottom of fresh water: 180
Depth to bottom of usable water: 580 560

Surface Pipe by Alternate: 1 X 2

Length of Surface Pipe Planned to be set: 211

Length of Conductor pipe required: none

Projected Total Depth: 3100

Formation at Total Depth: Lansing

Water Source for Drilling Operations:

... well farm pond X other

DWR Permit #:

Will Cores Be Taken? yes X no

If yes, proposed zones:

* A MIN. OF 580' OF SURFACE PIPE WOULD BE REQUIRED FOR ALT I.

CONTRACTOR: License #: 3232
Name: LIGHTNING WELL SERVICE

Well Drilled For: Well Class: Type Equipment:

X Oil ... Enh Rec ... Infield X Mud Rotary
... Gas ... Storage ... Pool Ext. ... Air Rotary
... OWWO ... Disposal ... Wildcat ... Cable
... Seismic; ... # of Holes ... Other
... Other

If OWWO: old well information as follows:

Operator: Shields Oil Producers, Inc.

Well Name: Sigle, B-1

Comp. Date: 09-03-92 Old Total Depth 3977

Directional, Deviated or Horizontal wellbore? yes X no

If yes, true vertical depth:

Bottom Hole Location:

AFFIDAVIT

The undersigned hereby affirms that the drilling, completion and eventual plugging of this well will comply with K.S.A. 55-101, et. seq.

It is agreed that the following minimum requirements will be met:

1. Notify the appropriate district office prior to spudding of well;
2. A copy of the approved notice of intent to drill shall be posted on each drilling rig;
3. The minimum amount of surface pipe as specified below shall be set by circulating cement to the top; in all cases surface pipe shall be set through all unconsolidated materials plus a minimum of 20 feet into the underlying formation;
4. If the well is dry hole, an agreement between the operator and the district office on plug length and placement is necessary prior to plugging;
5. The appropriate district office will be notified before well is either plugged or production casing is cemented in;
6. IF AN ALTERNATE II COMPLETION, PRODUCTION PIPE SHALL BE CEMENTED FROM BELOW ANY USABLE WATER TO SURFACE WITHIN 120 DAYS OF SPUD DATE. IN ALL CASES, NOTIFY DISTRICT OFFICE PRIOR TO ANY CEMENTING.

I hereby certify that the statements made herein are true and to the best of my knowledge and belief.

Date: 11-6-1995 Signature of Operator or Agent: Gary L. Brungardt Title: Owner

FOR KCC USE:
 API # 15- 141-202700001
 Conductor pipe required NONE feet
 Minimum surface pipe required 211' feet per Alt. X(2)
 Approved by: JB 11-8-95
 This authorization expires: 5-8-96
 (This authorization void if drilling not started within 6 months of effective date.)
 Spud date: _____ Agent: _____

REMEMBER TO:

- File Drill Pit Application (form CDP-1) with Intent to Drill;
- File Completion Form ACO-1 within 120 days of spud date;
- File acreage attribution plat according to field proration orders;
- Notify appropriate district office 48 hours prior to workover or re-entry;
- Submit plugging report (CP-4) after plugging is completed;
- Obtain written approval before disposing or injecting salt water.

Mail to: Conservation Division, 200 Colorado Derby Building, 202 W. First St., Wichita, Kansas 67202-1286.

10
10
123

IN ALL CASES PLOT THE INTENDED WELL ON THE PLAT BELOW

PLAT OF ACREAGE ATTRIBUTABLE TO A WELL IN A PRORATED OR SPACED FIELD

If the intended well is in a prorated or spaced field, please fully complete this side of the form. If the intended well is in a prorated or spaced field complete the plat below showing that the well will be properly located in relationship to other wells producing from the common source of supply. Please show all the wells within 1 mile of the boundaries of the proposed acreage attribution unit for gas wells and within 1/2 mile of the boundaries of the proposed acreage attribution unit for oil wells.

API NO. 15- _____
 OPERATOR _____
 LEASE _____
 WELL NUMBER _____
 FIELD _____



LOCATION OF WELL: COUNTY _____
 _____ feet from south/north line of section
 _____ feet from east/west line of section
 SECTION _____ TWP _____ RG _____

NUMBER OF ACRES ATTRIBUTABLE TO WELL _____
 QTR/QTR/QTR OF ACREAGE _____ - _____ - _____

IS SECTION _____ REGULAR or _____ IRREGULAR
IF SECTION IS IRREGULAR, LOCATE WELL FROM NEAREST CORNER BOUNDARY.

Section corner used: _____ NE _____ NW _____ SE _____ SW
 PLAT

(Show location of the well and shade attributable acreage for prorated or spaced wells.)
 (Show footage to the nearest lease or unit boundary line.)

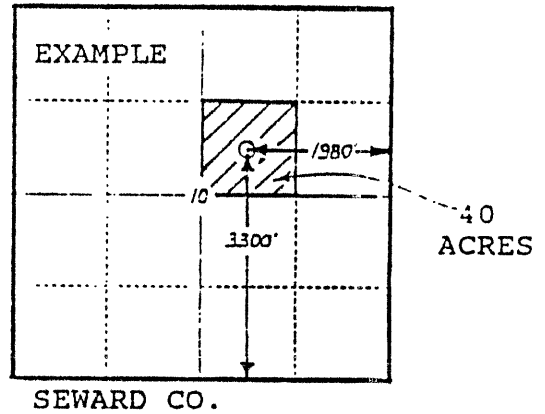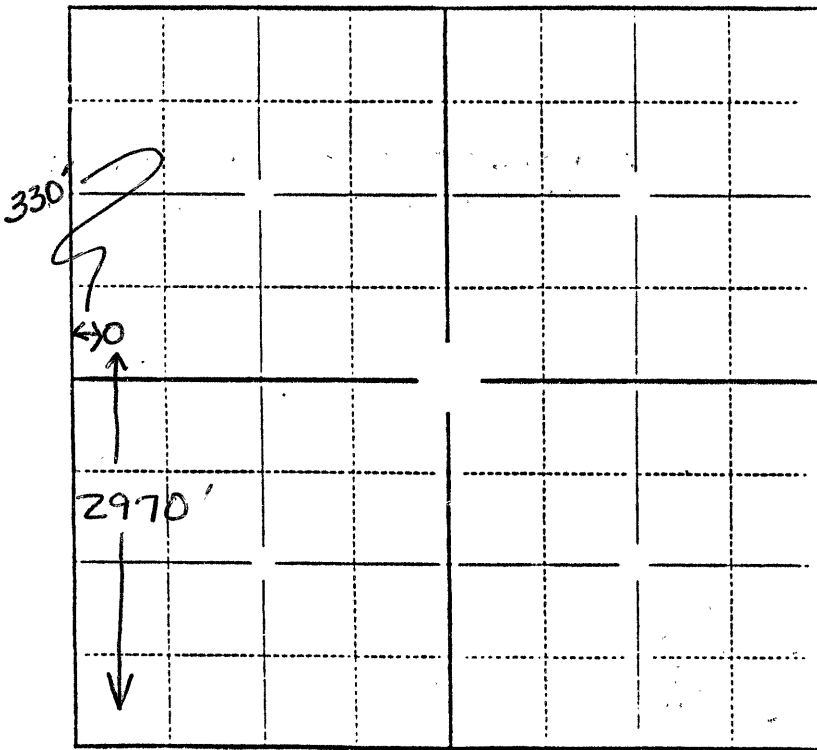

In plotting the proposed location of the well, you must show:

- 1) The manner in which you are using the depicted plat by identifying section lines, i.e. 1 section, 1 section with 8 surrounding sections, 4 sections, etc.;
- 2) the distance of the proposed drilling location from the section's south/north and east/west lines; and
- 3) the distance to the nearest lease or unit boundary line.