


WELL PLUGGING RECORD

Give All Information Completely  
Make Required Affidavit  
Mail or Deliver Report to:  
Conservation Division  
State Corporation Commission  
800 Bitting Building  
Wichita, Kansas

NORTH

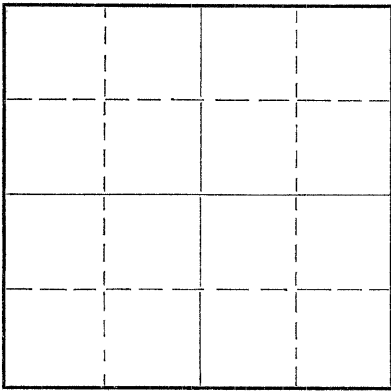

Locate well correctly on above  
Section Flat

Ottawa County, Sec. 22 Twp. 10 Rge. (E) 2 (W)  
Location as "NE/CNW $\frac{1}{4}$ SW $\frac{1}{4}$ " or footage from lines SW SW SE  
Lease Owner Westgate-Greenland Oil Company  
Lease Name Schlotz Well No. 1  
Office Address 1022 Union National Bank Building, Wichita 2, Kansas  
Character of Well (completed as Oil, Gas or Dry Hole) dry hole  
Date well completed May 8, 1949 19  
Application for plugging filed Orally-May 8, 1949 19  
Application for plugging approved May 8, 1949 19  
Plugging commenced May 8, 1949 19  
Plugging completed May 8, 1949 19  
Reason for abandonment of well or producing formation

If a producing well is abandoned, date of last production 19  
Was permission obtained from the Conservation Division or its agents before plugging was commenced? yes

Name of Conservation Agent who supervised plugging of this well R. E. Durkee  
Producing formation Depth to top Bottom Total Depth of Well Feet  
Show depth and thickness of all water, oil and gas formations.

OIL, GAS OR WATER RECORDS

CASING RECORD

Formation	Content	From	To	Size	Put In	Pulled Out
surface		0	158	8 5/8"	158	none

Describe in detail the manner in which the well was plugged, indicating where the mud fluid was placed and the method or methods used in introducing it into the hole. If cement or other plugs were used, state the character of same and depth placed, from feet to feet for each plug set.

Filled hole with heavy mud from 3508 to 158 feet  
Set plug and run 20 sacks cement  
Filled hole with heavy mud to 15 feet of cellar  
Set plug and run 5 sacks cement filling hole to cellar floor

05-17-1949

(If additional description is necessary, use BACK of this sheet)

Correspondence regarding this well should be addressed to Westgate-Greenland Oil Company  
Address 1022 Union National Bank Building, Wichita 2, Kansas

STATE OF Kansas, COUNTY OF Sedgwick, ss.  
G. E. Bitler (employee of owner) or (owner or operator) of the above-described well,  
being first duly sworn on oath, says: That I have knowledge of the facts, statements, and matters herein contained and the log of the above-described well as filed and that the same are true and correct. So help me God.

(Signature) G. E. Bitler

1022 Union National Bank Building, Wichita 2, Ks  
(Address)

SUBSCRIBED AND SWORN to before me this May day of May, 19 49

Esther Tinsell

Notary Public.

My commission expires May 25, 1949

**PLUGGING**  
FILE SEC 20410 R 20  
BOOK PAGE 96 LINE 17

15-143-00004-00-00

COMPANY: Westgate-Greenland Oil Company  
 CONTRACTOR: Mallard Drilling Company  
 FARM: Schlotz #1  
 LOCATION: SW/4 SW/4 SE/4  
 Section 22-10-2W Ottawa County, Kansas  
 COMMENCED: April 26, 1949  
 COMPLETED: May 8, 1949

0	to	158	Surface sand
158	to	400	Shale, red bed and lime
400	to	660	Shale and lime
660	to	860	Lime
860	to	1000	Sandy lime and shale
1000	to	1340	Shale and shells
1340	to	1715	Shale and shells
1715	to	1960	Shale and lime
1960	to	2070	Lime and shale
2070	to	2130	Shale and lime
2130	to	2180	Lime and shale
2180	to	2255	Lime and shale
2255	to	2710	Shale and lime
2710	to	2792	Shale
2792	to	2830	Lime and chert
2830	to	2867	Lime and chert
2867	to	2888	Chert
2888	to	2958	Lime and chert
2958	to	3008	Lime
3008	to	3058	Lime
3058	to	3148	Shale and lime
3148	to	3223	Shale and lime
3223	to	3303	Lime
3303	to	3383	Lime
3383	to	3453	Lime and shale
3453	to	3498	Shale and lime
3498	to	3508	Lime
		3508	T.D.

Set 158 feet of 8 5/8" surface pipe. Cemented with 100 sacks cement.

TOPS: Viola--3458      Mississipp--2792

Measurements taken from derrick floor.

DRY, ABANDONED AND PLUGGED

RECORDED  
 MAY 17 1949  
 ST. 05-17-1949  
 COMMISSION  
 KANSAS

C E R T I F I C A T E

I, C. C. Nelson, do hereby certify that the above and foregoing is a true and correct copy of the log of Schlotz #1, Ottawa County, Kansas, as reflected by files of the Mallard Drilling Company.

*C. C. Nelson*

Subscribed and sworn to before me a Notary Public, within and for Sedgwick County, Kansas, this 10th day of May 1949.

*Lawrence Wright*

12/4/52

PLUGGING  
 by Commission Expires  
 WILE SEC 77-20 R  
 BOOK PAGE 96