

CORRECTED

For KCC Use: 8-13-06
Effective Date: 2
District # 2
SGA? Yes No

NOTICE OF INTENT TO DRILL

Form must be Typed
Form must be Signed
All blanks must be Filled

Must be approved by KCC five (5) days prior to commencing well

Expected Spud Date Nov 26, 2006
month day year

OPERATOR: License# 9911
Name: HAR-KEN Agent OK
Address: 12028 N Pennsylvania
City/State/Zip: Oklahoma City, OK 73120
Contact Person: Stuart Kirk
Phone: 405 752-0318

CONTRACTOR: License# 6039
Name: L D Drilling

Spot East West
* SW - SE - SW Sec. 6 Twp. 17 S. R. 9
* 490 feet from N / S Line of Section
3,540' (900 + 2640) feet from E / W Line of Section
Is SECTION Regular Irregular?

(Note: Locate well on the Section Plat on reverse side)

County: Ellsworth
Lease Name: Schneweis Well #: 3

* Field Name: KOOTZ
Is this a Prorated / Spaced Field? Yes No

Target Formation(s): Arbuckle
* Nearest Lease or unit boundary: 490'

* Ground Surface Elevation: 1785 feet MSL

Water well within one-quarter mile: Yes No
Public water supply well within one mile: Yes No

Depth to bottom of fresh water: 75
Depth to bottom of usable water: 230

Surface Pipe by Alternate: 1 2
Length of Surface Pipe Planned to be set: 275

Length of Conductor Pipe required: _____
Projected Total Depth: 3300'

Formation at Total Depth: Arbuckle
Water Source for Drilling Operations:
 Well Farm Pond Other _____

DWR Permit #: _____
(Note: Apply for Permit with DWR)

Will Cores be taken? Yes No
If Yes, proposed zone: _____

Well Drilled For: Oil Gas OWWO Seismic; # of Holes Other
 Enh Rec Storage Disposal Other
Well Class: Infield Pool Ext. Wildcat Other
Type Equipment: Mud Rotary Air Rotary Cable

If OWWO: old well information as follows:
Operator: _____
Well Name: _____
Original Completion Date: _____ Original Total Depth: _____

Directional, Deviated or Horizontal wellbore? Yes No
If Yes, true vertical depth: _____

Bottom Hole Location: _____
KCC DKT #: _____

* WAS: 450' FSL Field Name: Stoltenberg NLUB: 450'
IS: 490' FSL Field Name: Kootz NLUB: 490'

AFFIDAVIT

* WAS: Elev. 1825 est.
IS: Elev. 1785

The undersigned hereby affirms that the drilling, completion and eventual plugging of this well will comply with K.S.A. 55 et. seq.
It is agreed that the following minimum requirements will be met:

1. Notify the appropriate district office **prior** to spudding of well;
2. A copy of the approved notice of intent to drill **shall be** posted on each drilling rig;
3. The minimum amount of surface pipe as specified below **shall be set** by circulating cement to the top; in all cases surface pipe **shall be set** through all unconsolidated materials plus a minimum of 20 feet into the underlying formation.
4. If the well is dry hole, an agreement between the operator and the district office on plug length and placement is necessary **prior to plugging**;
5. The appropriate district office will be notified before well is either plugged or production casing is cemented in;
6. If an ALTERNATE II COMPLETION, production pipe shall be cemented from below any usable water to surface within **120 days** of spud date.
Or pursuant to Appendix "B" - Eastern Kansas surface casing order #133,891-C, which applies to the KCC District 3 area, alternate II cementing must be completed within 30 days of the spud date or the well shall be plugged. **In all cases, NOTIFY district office** prior to any cementing.

I hereby certify that the statements made herein are true and to the best of my knowledge and belief.

Date: Nov 6 2006 Signature of Operator or Agent: Stuart Kirk Title: Agent

For KCC Use ONLY
API # 15 - 053-21190-0000
Conductor pipe required None feet
Minimum surface pipe required 250 feet per Alt. 1
Approved by: Per 8-8-06 / Per 11-9-06
This authorization expires: 2-8-07
(This authorization void if drilling not started within 6 months of approval date.)
Spud date: _____ Agent: _____

- Remember to:
- File Drill Pit Application (form CDP-1) with Intent to Drill;
 - File Completion Form ACO-1 within 120 days of spud date;
 - File acreage attribution plat according to field proration orders;
 - Notify appropriate district office 48 hours prior to workover or re-entry;
 - Submit plugging report (CP-4) after plugging is completed;
 - Obtain written approval before disposing or injecting salt water.
- If this permit has expired (See: authorized expiration date) please check the box below and return to the address below.

Well Not Drilled - Permit Expired
Signature of Operator or Agent: _____
Date: _____

RECEIVED

Mail to: KCC - Conservation Division, 130 S. Market - Room 2078, Wichita, Kansas NOV 8 2006

KCC WICHITA

6
17
9W

IN ALL CASES PLOT THE INTENDED WELL ON THE PLAT BELOW

CORRECTED

Plat of acreage attributable to a well in a prorated or spaced field



If the intended well is in a prorated or spaced field, please fully complete this side of the form. If the intended well is in a prorated or spaced field complete the plat below showing that the well will be properly located in relationship to other wells producing from the common source of supply. Please show all the wells and within 1 mile of the boundaries of the proposed acreage attribution unit for gas wells and within 1/2 mile of the boundaries of the proposed acreage attribution unit for oil wells.

API No. 15 - 053-21190-0000
Operator: HAR-KEN Agent OK
Lease: Schneweis
Well Number: 3
Field: Stoltenberg
Number of Acres attributable to well: 10
QTR / QTR / QTR of acreage: SW - SE - SW
Approximately

Location of Well: County: Ellsworth
490 feet from N / X S Line of Section
3,540' (900+2640) feet from X E / W Line of Section
Sec. 6 Twp. 17 S. R. 9
Is Section: Regular or X Irregular
If Section is Irregular, locate well from nearest corner boundary.
Section corner used: NE NW X SE SW

PLAT

(Show location of the well and shade attributable acreage for prorated or spaced wells.)
(Show footage to the nearest lease or unit boundary line.)

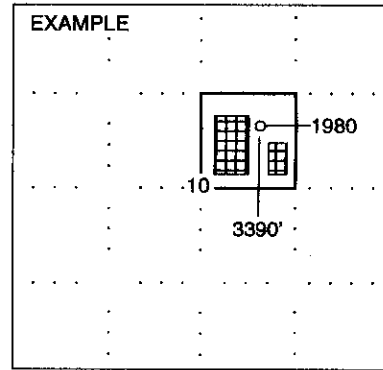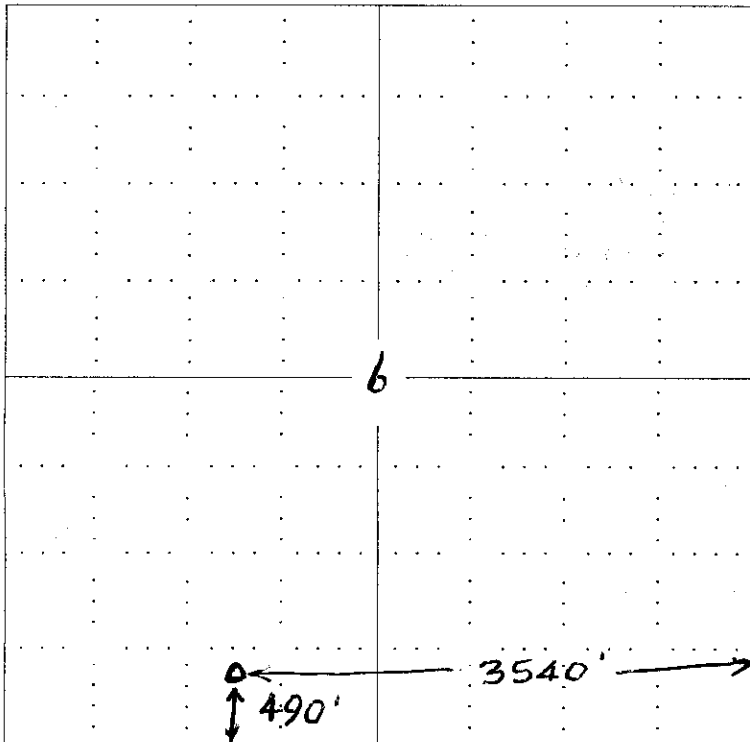

NOTE: In all cases locate the spot of the proposed drilling location.

In plotting the proposed location of the well, you must show:

- 1. The manner in which you are using the depicted plat by identifying section lines, i.e. 1 section, 1 section with 8 surrounding sections, 4 sections, etc.
2. The distance of the proposed drilling location from the section's south / north and east / west.
3. The distance to the nearest lease or unit boundary line.
4. If proposed location is located within a prorated or spaced field a certificate of acreage attribution plat must be attached: (CO-7 for oil wells; CG-8 for gas wells).