

STATE CORPORATION COMMISSION OF KANSAS  
OIL & GAS CONSERVATION DIVISION  
WELL COMPLETION OR RECOMPLETION FORM  
ACO-1 WELL HISTORY  
DESCRIPTION OF WELL AND LEASE

Operator: License # ... 3578  
Name .. Medallion Petroleum, Inc.  
Address ... 320 South Boston, Suite 200  
City/State/Zip ... Tulsa, OK 74103-3708

Purchaser .....

Operator Contact Person Lee C. Francis  
Phone (918)-585-2556

Contractor: License # .. 8241  
Name .. Emphasis Oil Operations

Wellsite Geologist Randy Sey  
Phone (918)-299-1013

Designate Type of Completion  
 New Well  Re-Entry  Workover  
  
 Oil  SMD  Temp Abd  
 Gas  Inj  Delayed Comp.  
 Dry  Other (Core, Water Supply etc.)

If ONWQ: old well info as follows:  
Operator ..  
Well Name ..  
Comp. Date ..... Old Total Depth.....

WELL HISTORY

Drilling Method:  
 Mud Rotary  Air Rotary  Cable  
3-29-88 ..... 4-7-88 ..... 4-7-88 .....  
Spud Date Date Reached TD Completion Date  
5320' .....  
Total Depth PBTD

Amount of Surface Pipe Set and Cemented at 420 feet  
Multiple Stage Cementing Collar Used?  Yes  No  
If yes, show depth set ..... feet  
If alternate 2 completion, cement circulated  
from ..... feet depth to ..... w/ ..... SX cmt  
Cement Company Name .....  
Invoice # .....

API NO. 15-... 181-20,277-00-00  
County... Sherman  
200' NE of  
Q. SW/4. NW/4.... Sec... 2. Twp. 9S. Rge. 40...  East  
 West

3300.... Ft North from Southeast Corner of Section  
4620.... Ft West from Southeast Corner of Section  
(Note: Locate well in section plat below)


Lease Name... Goodland Well #... 2-1

Field Name... Wildcat

Producing Formation... Dry & Abandoned

Elevation: Ground... 3692' KB... 3697'

Section Plat

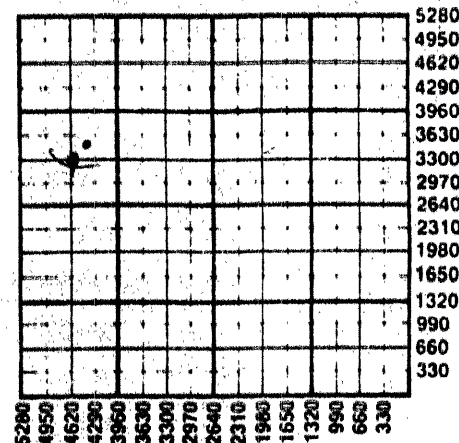

WATER SUPPLY INFORMATION

Disposition of Produced Water:  Disposal  
Docket # .....  Repressuring

Questions on this portion of the ACO-1 call:

Water Resources Board (913) 296-3717  
Source of Water:  Groundwater  
Division of Water Resources Permit # 21,556  
 Groundwater, 3300 Ft North from Southeast Corner  
(Well) 4620 Ft West from Southeast Corner of  
Sec 3 Twp 9S Rge 40 East  West  
 Surface Water ..... Ft North from Southeast Corner  
(Stream, pond etc) ..... Ft West from Southeast Corner  
Sec Twp Rge East West  
 Other (explain) .....  
(purchased from city, R.W.D. #)

INSTRUCTIONS: This form shall be completed in triplicate and filed with the Kansas Corporation Commission, 200 Colorado Derby Building, Wichita, Kansas 67202, within 120 days of the spud date of any well. Rule 82-3-130, 82-3-107 and 82-3-106 apply. Information on side two of this form will be held confidential for a period of 12 months if requested in writing and submitted with the form. See rule 82-3-107 for confidentiality in excess of 12 months. One copy of all wireline logs and drillers time log shall be attached with this form. Submit CP-4 form with all plugged wells. Submit CP-111 form with all temporarily abandoned wells.

All requirements of the statutes, rules and regulations promulgated to regulate the oil and gas industry have been fully complied with and the statements herein are complete and correct to the best of my knowledge.

Signature Lee C. Francis  
Title Petroleum Engineer Date 3/28/88  
Subscribed and sworn to before me this 28th day of April  
19 88  
Notary Public Christine Fletcher  
Date Commission Expires June 26, 1989

K.C.C. OFFICE USE ONLY  
 Letter of Confidentiality Attached  
 Wireline Log Received  
 Drillers Timelog Received  
RECEIVED  
STATE CORPORATION COMMISSION  
MAY 05 1988  
05-05-1988  
KGS SWD/Rep NGPA  
Plug Other  
Wichita, Kansas Form ACO-1 (5-86)

Sec. 2 Twp. 9 Rge. 40

Operator Name Medallion Petroleum, Inc. Lease Name Goodland Well # 2-1

Sec. 2 Twp. 9S Rge. 40  East  West County Sherman

WELL LOG

INSTRUCTIONS: Show important tops and base of formations penetrated. Detail all cores. Report all drill stem tests giving interval tested, time tool open and closed, flowing and shut-in pressures, whether shut-in pressure reached static level, hydrostatic pressures, bottom hole temperature, fluid recovery, and flow rates if gas to surface during test. Attach extra sheet if more space is needed. Attach copy of log.

Drill Stem Tests Taken  Yes  No  
 Samples Sent to Geological Survey  Yes  No  
 Cores Taken  Yes  No

Formation Description  
 Log  Sample

| Name                 | Top   | Bottom |
|----------------------|-------|--------|
| Permian              | 2586' | +1355' |
| Stone Corral         | 3170' | + 527' |
| Shawnee/Topeka       | 4102' | - 405' |
| Heebner Shale        | 4262' | - 565' |
| Toronto Limestone    | 4276' | - 579' |
| Lansing Kansas City  | 4334' | - 637' |
| Marmaton             | 4690' | - 993' |
| Cherokee             | 4886' | -1189' |
| Atoka                | 5048' | -1351' |
| Morrow Shale (STRAT) | 5114' | -1417' |
| Lower Morrow         | 5306' | -1509' |
| Mississippian        |       |        |
| St. Genevieve        | 5282' | -1516' |
| TD (Driller)         | 5320' | -1623' |
| TD (Log)             | 5319' | -1622' |

RELEASED

JUN 12 1989

FROM CONFIDENTIAL

| CASING RECORD <input checked="" type="checkbox"/> New <input type="checkbox"/> Used |   |   |                |  |                |             |                            |
|---|---|---|----------------|--|----------------|-------------|----------------------------|
| Report all strings set-conductor, surface, intermediate, production, etc.           |   |   |                |  |                |             |                            |
| Purpose of String   | Size Hole Drilled                           | Size Casing Set (in O.D.)   | Weight Lbs/Ft. | Setting Depth  | Type of Cement | #Sacks Used | Type and Percent Additives |
| Surface   | 12-1/4"                                     | 8-5/8"  | 24#            | 420 KB   | 60/40 POZ      | 200         | 2% Gel & 3% CC             |
|   |   |   |                |  |                |             |                            |
|   |   |   |                |  |                |             |                            |
|   |   |   |                |  |                |             |                            |
| PERFORATION RECORD  |   |   |                | Acid, Fracture, Shot, Cement Squeeze Record                        |                |             |                            |
| Shots Per Foot  | Specify Footage of Each Interval Perforated |   |                | Amount and Kind of Material Used                                   |                |             | Depth                      |
|   |   |   |                |  |                |             |                            |
|   |   |   |                |  |                |             |                            |
|   |   |   |                |  |                |             |                            |
|   |   |   |                |  |                |             |                            |
| TUBING RECORD   |   |   |                | Liner Run <input type="checkbox"/> Yes <input type="checkbox"/> No |                |             |                            |
| Size  | Set At                                      | Packer at   |                |  |                |             |                            |
|   |   |   |                |  |                |             |                            |
| Date of First Production  |   | Producing Method  |                |  |                |             |                            |
|   |   | <input type="checkbox"/> Flowing <input type="checkbox"/> Pumping <input type="checkbox"/> Gas Lift <input type="checkbox"/> Other (explain)..... |                |  |                |             |                            |
| Estimated Production Per 24 Hours   | Oil   | Gas   | Water          | Gas-Oil Ratio  | Gravity        |             |                            |
|   | Bbls  | MCF   | Bbls           | CFPB   |                |             |                            |
|   |   |   |                |  |                |             |                            |

METHOD OF COMPLETION

Production Interval

Disposition of gas:  Vented  Open Hole  Perforation  
 Sold  Other (Specify) .....  
 Used on Lease  Dually Completed .....  
 Commingled .....