

STATE OF KANSAS  
STATE CORPORATION COMMISSION

15-181-00010-00-00


WELL PLUGGING RECORD

Give All Information Completely  
Make Required Affidavit  
Mail or Deliver Report to:  
Conservation Division  
State Corporation Commission  
211 No. Broadway  
Wichita, Kansas

Sherman

County. Sec. 11 Twp. 9 Rge. 37 (E) (W)

Location as "NE/CNW'SW" or footage from lines NENE NE  
Lease Owner Phillips Petroleum Company  
Lease Name (Haddock) Goodland Well No. 1  
Office Address R Goodland, Kansas  
Character of Well (completed as Oil, Gas or Dry Hole) Dry Hole  
Date well completed March 4, 1958 19  
Application for plugging filed March 4, 1958 19  
Application for plugging approved March 4, 1958 19  
Plugging commenced March 4, 1958 19  
Plugging completed March 4, 1958 19  
Reason for abandonment of well or producing formation \_\_\_\_\_

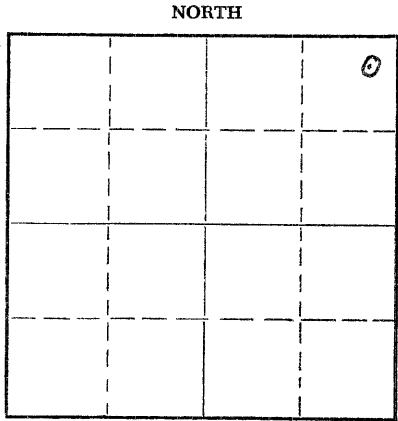

Locate well correctly on above  
Section Plat

If a producing well is abandoned, date of last production \_\_\_\_\_ 19  
Was permission obtained from the Conservation Division or its agents before plugging was commenced? Yes

Name of Conservation Agent who supervised plugging of this well A. D. Fabricius  
Producing formation \_\_\_\_\_ Depth to top \_\_\_\_\_ Bottom \_\_\_\_\_ Total Depth of Well 5168 Feet  
Show depth and thickness of all water, oil and gas formations.

OIL, GAS OR WATER RECORDS

CASING RECORD

FORMATION	CONTENT	FROM	TO	SIZE	PUT IN	PULLED OUT

Describe in detail the manner in which the well was plugged, indicating where the mud fluid was placed and the method or methods used in introducing it into the hole. If cement or other plugs were used, state the character of same and depth placed, from \_\_\_\_\_ feet to \_\_\_\_\_ feet for each plug set.

Gun pits and place heavy mud in hole.  
Run 30 sacks of cement from 2960 ft. to 2880 ft.  
This would be a 90 ft plug from 40 ft. in the anhydrite to 50 ft. in red shale.  
Come up the hole and run 30 sacks of cement from 280 ft. to 180 ft.  
This would be a 100 ft. plug from 50 ft. below the casing to 50 ft in the casing.  
Run ten sacks 30 ft. to surface.

RECEIVED  
STATE CORPORATION COMMISSION

MAY 26 1958  
05-26-1958  
CONSERVATION DIVISION  
WICHITA, KANSAS

Name of Plugging Contractor Halliburton (If additional description is necessary, use BACK of this sheet)  
Address Hill City, Kansas

STATE OF Kansas, COUNTY OF Sherman, ss.  
\_\_\_\_\_  
(employee of owner) or (owner or operator) of the above-described well, being first duly sworn on oath, says: That I have knowledge of the facts, statements, and matters herein contained and the log of the above-described well as filed and that the same are true and correct. So help me God.  
(Signature) J. H. Shutt

SUBSCRIBED AND SWORN TO before me this 24 day of May, 1958  
My commission expires June 18 1960  
Hulma M. Hudson  
Notary Public.

PLUGGING  
C. 11 T. 9 R. 37W  
PAGE 88 LINE 32