


15-181-00016-00-00
WELL PLUGGING RECORD

NORTH

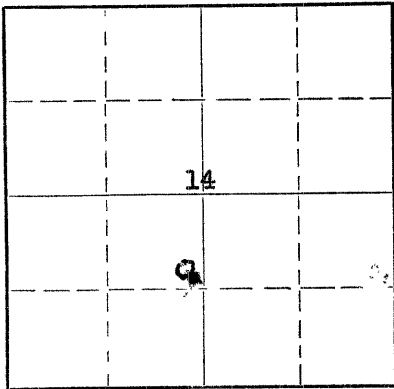

Locate well correctly on above
Section Plat

Sherman County. Sec. 14 Twp. 9 Rge. 40 (E) W (W)
Location as "NE/CNW $\frac{1}{4}$ SW $\frac{1}{4}$ " or footage from lines SE NE SW
Lease Owner O. M. Slosson
Lease Name Riley Well No. 1
Office Address 1145 E. Burnette, Long Beach 6, California
Character of Well (completed as Oil, Gas or Dry Hole) Dry Hole
Date well completed August 15, 19 53
Application for plugging filed August 15, 19 53
Application for plugging approved August 15, 19 53
Plugging commenced August 15, 19 53
Plugging completed August 15, 19 53
Reason for abandonment of well or producing formation No commercial showing of
oil or gas were found in hole.
If a producing well is abandoned, date of last production - - - - - 19 - -
Was permission obtained from the Conservation Division or its agents before plugging was commenced? Yes

Name of Conservation Agent who supervised plugging of this well Eldon Petty
Producing formation None Depth to top - - - Bottom - - - - - Total Depth of Well 5315 Feet
Show depth and thickness of all water, oil and gas formations.

OIL, GAS OR WATER RECORDS

CASING RECORD

FORMATION	CONTENT	FROM	TO	SIZE	PUT IN	PULLED OUT
				10 3/4	320	None

Describe in detail the manner in which the well was plugged, indicating where the mud fluid was placed and the method or methods used in introducing it into the hole. If cement or other plugs were used, state the character of same and depth placed, from 300 feet to 35 feet for each plug set.
Set plug at 300 feet. Run 1/2 sack of hulls and 20 sacks of cement by Company Tools.
Fill to 35 feet of top where second plug and 10 sacks of sement were set.

RECEIVED
STATE CORPORATION COMMISSION
AUG 29 1953
CONSERVATION DIVISION
Wichita, Kansas

(If additional description is necessary, use BACK of this sheet)
Name of Plugging Contractor Wycoff Drilling Company
Address Oakley, Kansas

STATE OF California, COUNTY OF Los Angeles, ss.
I, F. A. Graser (employee of owner) or (owner or operator) of the above-described well, being first duly sworn on oath, says: That I have knowledge of the facts, statements, and matters herein contained and the log of the above-described well as filed and that the same are true and correct. So help me God.


(Signature) [Signature]
421 Oak Lane San Gabriel, Calif. (Address)

SUBSCRIBED AND SWORN TO before me this 27th day of August, 19 53

William A. Wilson

Notary Public.

My Commission Expires March 16, 1955
My commission expires

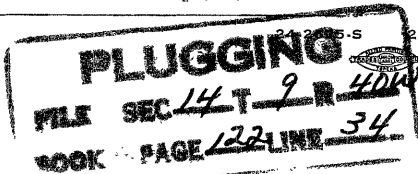

Log of

O.M. SLOSSON #1 (RILEY)

Sherman County, Kansas

15-181 - 00016 - 00 - 00

RECEIVED
STATE CORPORATION COMMISSION

AUG 22 1953

08-29-1953
CONSERVATION DIVISION

Location: C SE/4 NE/4 SW/4 Sec. 14, T.9S, R.40W. Wichita, Kansas
 Elevation: 3739 (Grd) 3744 (KB) All measurements from K.B.
 Commenced Drilling: 7-12-53 Completed Drilling: 8-15-53
 Initial Production: Dry and abandoned.

Depth	Formation
0-40'	Surface soil
280	Sand and shells
322	Shale and shells
	10-3/4" casing cemented at 320' using 250 Sx
1060	Gray shale - some chalk
1505	Gray shale and marl
1555	Gray shale, marl, thin stks white l.s.
1630	Brittle gray shale and white l.s.
2050	Steel gray shale, stks calcareous shale and white l.s., fossiliferous in part
2130	Slate gray shale and sandy shale strks fine white sand with white chalky matrix
2475	Gray shale thin stks fine white sand
2620	Pastel shales of gray, maroon, lavender and black gritty shale, stks white l.s., little chert and pink l.s. at base
2660	Gray shale, rounded calcareous pebbles
3320	Red shale and sandy shale stks anhydrite and gypsum, little sand
3565	Red shale stks black shale and anhydrite
3710	Red shale stks green, gray and blk shale and anhydrite
4030	Red and black shale stks l.s.
4070	Red and soft gray shale stks l.s.
4120	L.s. stks red and gray shale
4770	Gray and red shale streaked with white, buff and gray l.s.
5105	Gray and black shale streaked with cherty white, buff, brown and black l.s.
5235	Gray and black shale stks l.s. and glauconitic fine and coarse sand - considerable lignite
5315 T.D.	Limestone and gray shale

I, F.A. Graser, being first duly sworn according to law on oath, depose and state that to the best of my knowledge and belief, the above and foregoing is a full, true and correct log of the well above described.

Dated at Long Beach, California, this 27th day of August, 1953.



STATE OF CALIFORNIA,

County of Los Angeles.

ss.

15-181 - 00016-00-00

PLUGGING

FILE SEC 14 T 9 R 40W

BOOK PAGE 122 LINE 34

ON THIS 27th day of August, A.D., 1953, before me,
William A. Wilson
a Notary Public in and for said County and State, personally appeared
F. A. Fraser.

_____, known to me,
to be the person whose name is subscribed to the within
Instrument, and acknowledged to me that he executed the same.

IN WITNESS WHEREOF, I have hereunto set my hand and affixed my official seal
the day and year in this certificate first above written.

William A. Wilson

Notary Public in and for said County and State.

