

For KCC Use: 11-18-06  
 Effective Date: \_\_\_\_\_  
 District # 4  
 SGA?  Yes  No

KANSAS CORPORATION COMMISSION  
 OIL & GAS CONSERVATION DIVISION

Form C-1  
 December 2002  
**Form must be Typed**  
**Form must be Signed**  
**All blanks must be Filled**

**NOTICE OF INTENT TO DRILL**

Must be approved by KCC five (5) days prior to commencing well

Expected Spud Date December 10 2006  
 month day year

OPERATOR: License# 5030  
 Name: Vess Oil Corporation  
 Address: 8100 E. 22nd St North, Bldg. 300  
 City/State/Zip: Wichita, KS 67226  
 Contact Person: W.R. Horgan  
 Phone: 316-682-1537 X102

CONTRACTOR: License# 6039  
 Name: L. D. Drilling Co., Inc.

|   |   |   |
|---|---|---|
| <b>Well Drilled For:</b>  | <b>Well Class:</b>  | <b>Type Equipment:</b>  |
| <input checked="" type="checkbox"/> Oil <input checked="" type="checkbox"/> Enh Rec | <input checked="" type="checkbox"/> Infield <input checked="" type="checkbox"/> Pool Ext. | <input checked="" type="checkbox"/> Mud Rotary <input checked="" type="checkbox"/> Air Rotary |
| <input type="checkbox"/> Gas <input type="checkbox"/> Storage                       | <input type="checkbox"/> Wildcat <input type="checkbox"/> Other                           | <input type="checkbox"/> Cable  |
| <input type="checkbox"/> OWWO <input type="checkbox"/> Disposal                     |   |   |
| <input type="checkbox"/> Seismic; # of Holes  |   |   |
| <input type="checkbox"/> Other  |   |   |

If OWWO: old well information as follows:  
 Operator: \_\_\_\_\_  
 Well Name: \_\_\_\_\_  
 Original Completion Date: \_\_\_\_\_ Original Total Depth: \_\_\_\_\_  
 Directional, Deviated or Horizontal wellbore?  Yes  No  
 If Yes, true vertical depth: \_\_\_\_\_  
 Bottom Hole Location: \_\_\_\_\_  
 KCC DKT #: \_\_\_\_\_

Spot  East  
 SE SW SW Sec. 25 Twp. 11S S. R. 17  West  
340' feet from  N /  S Line of Section  
880' feet from  E /  W Line of Section

Is SECTION  Regular  Irregular?

(Note: Locate well on the Section Plat on reverse side)

County: Ellis  
 Lease Name: Colahan B Well #: #29  
 Field Name: Bemis Shutts

Is this a Prorated / Spaced Field?  Yes  No

Target Information(s): Arbuckle

Nearest Lease or unit boundary: 340'

Ground Surface Elevation: Est. 2080' feet MSL

Water well within one-quarter mile:  Yes  No

Public water supply well within one mile:  Yes  No

Depth to bottom of fresh water: 180

Depth to bottom of usable water: 248 750

Surface Pipe by Alternate:  1  2

Length of Surface Pipe Planned to be set: 1210'

Length of Conductor Pipe required: \_\_\_\_\_

Projected Total Depth: 3600'

Formation at Total Depth: Arbuckle

Water Source for Drilling Operations:  Well  Farm Pond  Other \_\_\_\_\_

DWR Permit #: \_\_\_\_\_

(Note: Apply for Permit with DWR )

Will Cores be taken?  Yes  No

If Yes, proposed zone: \_\_\_\_\_

**AFFIDAVIT**

The undersigned hereby affirms that the drilling, completion and eventual plugging of this well will comply with K.S.A. 55 et. seq.

It is agreed that the following minimum requirements will be met:

1. Notify the appropriate district office **prior** to spudding of well;
2. A copy of the approved notice of intent to drill **shall be posted** on each drilling rig;
3. The minimum amount of surface pipe as specified below **shall be set** by circulating cement to the top; in all cases surface pipe **shall be set** through all unconsolidated materials plus a minimum of 20 feet into the underlying formation.
4. If the well is dry hole, an agreement between the operator and the district office on plug length and placement is necessary **prior to plugging**;
5. The appropriate district office will be notified before well is either plugged or production casing is cemented in;
6. If an ALTERNATE II COMPLETION, production pipe shall be cemented from below any usable water to surface within **120 days** of spud date.  
 Or pursuant to Appendix "B" - Eastern Kansas surface casing order #133,891-C, which applies to the KCC District 3 area, alternate II cementing must be completed within 30 days of the spud date or the well shall be plugged. **In all cases, NOTIFY district office** prior to any cementing.

I hereby certify that the statements made herein are true and to the best of my knowledge and belief.

Date: 11/6/06 Signature of Operator or Agent: [Signature] Title: Operations Engineer

**For KCC Use ONLY**  
 API # 15 - 051-25590-0000  
 Conductor pipe required None feet  
 Minimum surface pipe required 800 feet per Alt. 1  
 Approved by: RH 11-13-06  
 This authorization expires: 5-13-07  
 (This authorization void if drilling not started within 6 months of effective date.)  
 Spud date: \_\_\_\_\_ Agent: \_\_\_\_\_

**Remember to:**

- File Drill Bit Application (form CDP-1) with Intent to Drill;
- File Completion Form ACO-1 within 120 days of spud date;
- File acreage attribution plat according to field proration orders;
- Notify appropriate district office 48 hours prior to workover or re-entry;
- Submit plugging report (CP-4) after plugging is completed;
- Obtain written approval before disposing or injecting salt water.
- If this permit has expired (See: authorized expiration date) please check the box below and return to the address below.

Well Not Drilled - Permit Expired  
 Signature of Operator or Agent: \_\_\_\_\_  
 Date: \_\_\_\_\_

**RECEIVED**

Mail to: KCC - Conservation Division, 130 S. Market - Room 2078, Wichita, Kansas NOV 08 2006

KCC WICHITA

25  
11  
17W

**IN ALL CASES PLOT THE INTENDED WELL ON THE PLAT BELOW**

*Plat of acreage attributable to a well in a prorated or spaced field*

**If the intended well is in a prorated or spaced field, please fully complete this side of the form.** If the intended well is in a prorated or spaced field complete the plat below showing that the well will be properly located in relationship to other wells producing from the common source of supply. Please show all the wells and within 1 mile of the boundaries of the proposed acreage attribution unit for gas wells and within 1/2 mile of the boundaries of the proposed acreage attribution unit for oil wells.

API No. 15 - OSI-25590-0000  
Operator: Vess Oil Corporation  
Lease: Colahan B  
Well Number: #29  
Field: Bemis Shutts

Number of Acres attributable to well: \_\_\_\_\_  
QTR / QTR / QTR of acreage: SE - SW - SW

Location of Well: County: Ellis  
340' feet from  N /  S Line of Section  
880' feet from  E /  W Line of Section  
Sec. 25 Twp. 11S S. R. 17  East  West

Is Section:  Regular or  Irregular



**If Section is Irregular, locate well from nearest corner boundary.**

Section corner used:  NE  NW  SE  SW

**PLAT**

*(Show location of the well and shade attributable acreage for prorated or spaced wells.)*

*(Show footage to the nearest lease or unit boundary line.)*

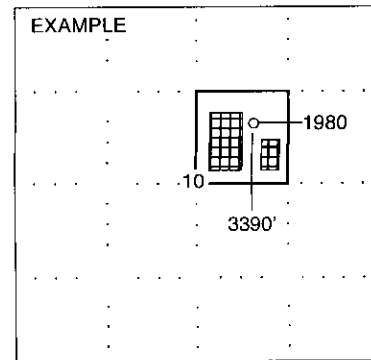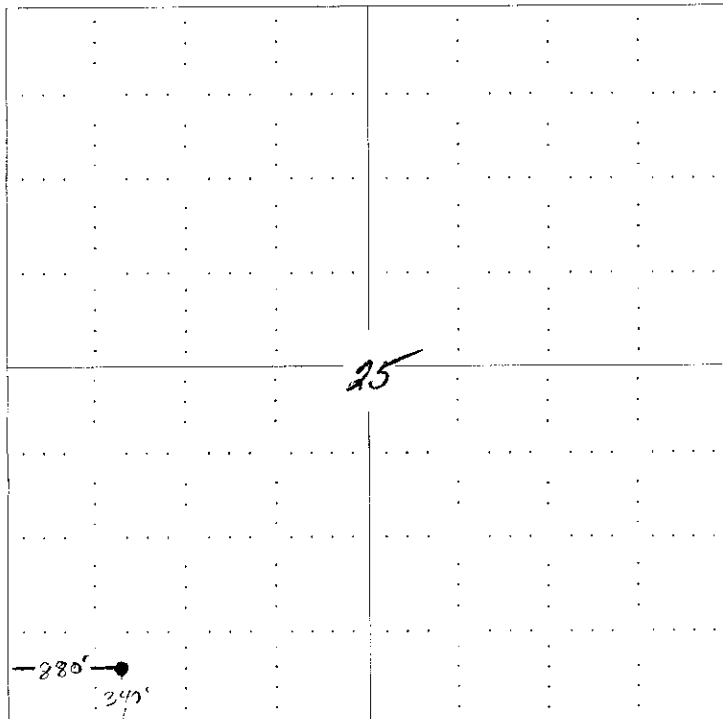

SEWARD CO.

**NOTE: In all cases locate the spot of the proposed drilling location.**

**In plotting the proposed location of the well, you must show:**

1. The manner in which you are using the depicted plat by identifying section lines, i.e. 1 section, 1 section with 8 surrounding sections, 4 sections, etc.
2. The distance of the proposed drilling location from the section's south / north and east / west.
3. The distance to the nearest lease or unit boundary line.
4. If proposed location is located within a prorated or spaced field a certificate of acreage attribution plat must be attached (CG-8 for oil wells; CG-8 for gas wells).

RECEIVED


NOV 08 2008

KCC WICHITA

**KANSAS CORPORATION COMMISSION  
OIL & GAS CONSERVATION DIVISION  
APPLICATION FOR SURFACE PIT**

Form CDP-1  
April 2004  
Form must be Typed

*Submit in Duplicate*

|  |  |   |
|--|--|---|
| Operator Name: <b>VESS OIL CORPORATION</b>   |  | License Number: <b>5030</b>   |
| Operator Address: <b>8100 E. 22nd Street North, Bldg. 300, Wichita, KS 67226</b>   |  |   |
| Contact Person: <b>W.R. Horigan</b>  |  | Phone Number: ( <b>316</b> ) <b>682 - 1537 X103</b>   |
| Lease Name & Well No.: <b>Colahan B #29</b>  |  | Pit Location (QQQQ):<br>110'NW <u>SE</u> <u>SW</u> <u>SW</u><br>Sec. <u>25</u> Twp. <u>11S</u> R. <u>17</u> <input type="checkbox"/> East <input checked="" type="checkbox"/> West<br><u>340'</u> Feet from <input type="checkbox"/> North / <input checked="" type="checkbox"/> South Line of Section<br><u>880'</u> Feet from <input type="checkbox"/> East / <input checked="" type="checkbox"/> West Line of Section<br><b>Ellis</b> County |
| Type of Pit:<br><input type="checkbox"/> Emergency Pit <input type="checkbox"/> Burn Pit<br><input type="checkbox"/> Settling Pit <input checked="" type="checkbox"/> Drilling Pit<br><input type="checkbox"/> Workover Pit <input type="checkbox"/> Haul-Off Pit<br><small>(If WP Supply API No. or Year Drilled)</small> | Pit is:<br><input checked="" type="checkbox"/> Proposed <input type="checkbox"/> Existing<br>If Existing, date constructed: _____<br>Pit capacity:<br><b>6000</b> (bbls) |   |
| Is the pit located in a Sensitive Ground Water Area? <input type="checkbox"/> Yes <input checked="" type="checkbox"/> No   |  | Chloride concentration: _____ mg/l<br><small>(For Emergency Pits and Settling Pits only)</small>  |
| Is the bottom below ground level?<br><input checked="" type="checkbox"/> Yes <input type="checkbox"/> No   | Artificial Liner?<br><input type="checkbox"/> Yes <input checked="" type="checkbox"/> No   | How is the pit lined if a plastic liner is not used?<br><b>bentonite gel</b>  |
| Pit dimensions (all but working pits): <u>80</u> Length (feet) <u>80</u> Width (feet) <u>N/A</u> <b>Steel Pits</b><br>Depth from ground level to deepest point: <u>6</u> (feet)  |  |   |
| If the pit is lined give a brief description of the liner material, thickness and installation procedure.<br><b>N/A</b>  |  | Describe procedures for periodic maintenance and determining liner integrity, including any special monitoring.<br><b>N/A</b>   |
| Distance to nearest water well within one-mile of pit<br><u>N/A</u> feet    Depth of water well _____ feet   |  | Depth to shallowest fresh water _____ feet.<br>Source of information:<br>_____ measured    _____ well owner    _____ electric log    _____ KDWR   |
| <b>Emergency, Settling and Burn Pits ONLY:</b><br>Producing Formation: _____<br>Number of producing wells on lease: _____<br>Barrels of fluid produced daily: _____<br>Does the slope from the tank battery allow all spilled fluids to flow into the pit? <input type="checkbox"/> Yes <input type="checkbox"/> No        |  | <b>Drilling, Workover and Haul-Off Pits ONLY:</b><br>Type of material utilized in drilling/workover: <u>fresh water and mud</u><br>Number of working pits to be utilized: <u>3</u><br>Abandonment procedure: <u>Dewatered and allowed to dry.</u><br><u>Backfilled and compacted.</u><br>Drill pits must be closed within 365 days of spud date.  |
| I hereby certify that the above statements are true and correct to the best of my knowledge and belief.  |  |   |
| <u>11/6/06</u><br>Date   |  | <br>Signature of Applicant or Agent   |

15-051-25590-0220

|  |   |  |
|--|---|--|
| <b>KCC OFFICE USE ONLY</b>   |   |  |
| Date Received: <u>11/8/06</u> Permit Number: _____ Permit Date: <u>11/8/06</u> | <b>RECEIVED</b> <input type="checkbox"/> Yes <input checked="" type="checkbox"/> No |  |

Mail to: KCC - Conservation Division, 130 S. Market - Room 2078, Wichita, Kansas 67202  
NOV 8 2006

**KCC WICHITA**