


WELL PLUGGING RECORD

Give All Information Completely
Make Required Affidavit
Mail or Deliver Report to:
Conservation Division
State Corporation Commission
211 No. Broadway
Wichita, Kansas

Sherman County. Sec. 16 Twp. 9S Rge. 40W (~~EX~~) (W)

Location as "NE/CNW/SW" or footage from lines C SE NW
Lease Owner D. R. Lauck Oil Company, Inc.
Lease Name Philbrick Well No. 1
Office Address 301 S. Broadway, Wichita, Kansas
Character of Well (completed as Oil, Gas or Dry Hole) Dry Hole
Date well completed August 13, 19 65
Application for plugging filed August 13, 19 65
Application for plugging approved August 13, 19 65
Plugging commenced August 13, 19 65
Plugging completed August 13, 19 65
Reason for abandonment of well or producing formation Dry Hole

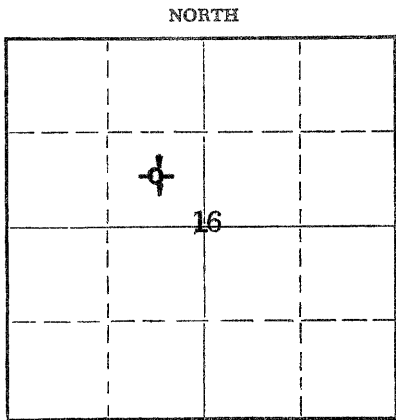

Locate well correctly on above Section Plat

If a producing well is abandoned, date of last production _____ 19____
Was permission obtained from the Conservation Division or its agents before plugging was commenced? Yes

Name of Conservation Agent who supervised plugging of this well W. L. Nichols
Producing formation _____ Depth to top _____ Bottom _____ Total Depth of Well 5393 Feet
Show depth and thickness of all water, oil and gas formations.

OIL, GAS OR WATER RECORDS

CASING RECORD

FORMATION	CONTENT	FRDM	TD	SIZE	PUT IN	PULLED OUT
		0'	300'	8-5/8"	300'	None

Describe in detail the manner in which the well was plugged, indicating where the mud fluid was placed and the method or methods used in introducing it into the hole. If cement or other plugs were used, state the character of same and depth placed, from _____ feet to _____ feet for each plug set.

5393-660' Mud
660-656' Plug
656-616' Cement, 20 sacks
616-300' Mud
300-296' Plug
296-256' Cement (20 sacks) & Hulls
256- 40' Mud
40- 36' Plug
36- 6' Cement (10 sacks) & Hulls
(Bottom of Cellar)

RECEIVED
STATE CORPORATION COMMISSION
SEP 10 1965
9-10-1965
CONSERVATION DIVISION
Wichita, Kansas

(If additional description is necessary, use BACK of this sheet)

Name of Plugging Contractor Lauck Drilling Company, Incorporated
Address 301 S. Broadway, Wichita, Kansas

STATE OF KANSAS, COUNTY OF SEDGWICK, ss.
John H. Knightley (employee of owner) or (~~owner~~) of the above-described well, being first duly sworn on oath, says: That I have knowledge of the facts, statements, and matters herein contained and the log of the above-described well as filed and that the same are true and correct. So help me God.

(Signature) John H. Knightley
301 S. Broadway, Wichita, Kansas
(Address)

SUBSCRIBED AND SWORN TO before me this 9th day of September, 19 65

My commission expires March 12, 1967 Stella J. Lipps Notary Public.

D. R. Lauck Oil Company, Inc.

15-181-30011-00-00

Philbrick #1

C SE NW Sec. 16-9S-40W
Sherman County, Kansas

Commenced: July 22, 1965
Completed: August 13, 1965

Casing Record: 300' 8-5/8" Cemented with 200 sacks Cement,
4 sacks Calcium Chloride.

Elevation: GR 3760; DF 3763; KB 3765.

Drillers Log

Tops

Surface Clay	52
Sand	250
Shale	300
Shale & Shells	1321
Shale & Clay	1690
Shale & Shells	2020
Sand	2080
Shale, Clay, some Pyrite	2252
Shale, Clay	2385
Sand & Shale	2525
Shale & Shells	2601
Shale, Shells, Sand	2750
Shale & Shells	3002
Shale, Pyrite, Anhydrite & Red Bed	3060
Shale & Shells	3304
Red Bed, Shale, Anydrite	3454
Sandy Shale, Anhydrite & Red Bed	3559
Shale & Lime	3670
Shale, Red Bed & Lime	3730
Lime	3765
Shale, Shells & Lime	3885
Lime & Shale	3984
Shale & Lime	4073
Lime & Shale	4185
Shale & Lime	4275
Lime	4399
Shale & Lime	4485
Lime	4735
Shale & Lime	4800
Lime	4843
Cherty Lime	4880
Lime	5125
Shale & Lime	5157
Shale & Sand	5180
Shale & Lime	5228
Shale & Sand	5232
Lime	5248
Sand & Shale	5269
Lime	5280
Shale, Chert, Sand	5301
Lime	5393 RTD

	Samples	Welex
Ft. Hays		1560+2205
Greenhorn		1815+1950
Dakota		2010+1755
Blaine	3000+765	2990+775
Anhydrite	3190+575	3184+581
Heebner	4363-598	4358-593
Toronto	4393-628	4392-627
Lansing	4414-649	4410-645
Cherokee	4919-1154	4915-1150
Morrow Shale	5125-1360	5121-1356
Morrow Sand	5148-1383	5146-1381
Mississippian		
St. Louis	5283-1518	5280-1515
Spergen	5292-1527	5294-1529
Warsaw	5352-1587	5352-1587
Total Depth	5393-1628	5392-1627

DST #1 (S) 5310-43, open 1 hour with weak
blow 40 minutes. Recovered 120'
mud.

ISIP 1219#/30 min.
FSIP 1040#/30 min.
IFP 41#
FFP 83#

RECEIVED
STATE CORPORATION COMMISSION

D&A

SEP 10 1965
09-10-1965
CONSERVATION DIVISION
Wichita, Kansas

I hereby certify that this is a true and correct
log of the above mentioned well, to the best
of my knowledge and belief.

John A. Knightley
Subscribed and sworn to before me this

9th day of Sept. 1965

Stella J. Lippa
Notary Public

My commission expires 3-12-69