


STATE OF KANSAS
STATE CORPORATION COMMISSION

WELL PLUGGING RECORD

Give All Information Completely
Make Required Affidavit
Mail or Deliver Report to
Conservation Division
State Corporation Comm.
245 North Water
Wichita, KS 67202

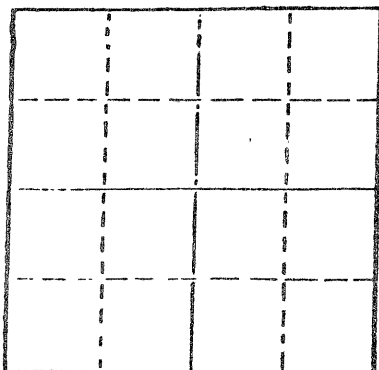

Locate well correctly on above
Section Plat

Osborne County, Sec. 2 Twp. 10 Rge. 15W E/W
Location as "NE/CNW 1/4 SW 1/4" or footage from lines
NW NE NW

Lease Owner Lawbanco Drilling, Inc.

Lease Name Finnesy Well No. 1

Office Address Box 289 Natoma, Kansas 67651

Character of Well (Completed as Oil, Gas or Dry Hole)
dry hole

Date Well completed 10-10 1981

Application for plugging filed 10-10 1981

Application for plugging approved 10-10 1981

Plugging commenced 9:30 P.M. 10-10 1981

Plugging completed 11:00 P.M. 10-10- 1981

Reason for abandonment of well or producing formation
dry

If a producing well is abandoned, date of last production
19

Was permission obtained from the Conservation Division or
its agents before plugging was commenced? yes

Name of Conservation Agent who supervised plugging of this well Marion Schmidt

Producing formation _____ Depth to top _____ Bottom _____ Total Depth of Well _____

Show depth and thickness of all water, oil and gas formations.

OIL, GAS OR WATER RECORDS

CASING RECORD

FORMATION	CONTENT	FROM	TO	SIZE	PUT IN	PULLED OUT

Describe in detail the manner in which the well was plugged, indicating where the mud fluid was placed and the method or methods used in introducing it into the hold. If cement or other plugs were used, state the character of same and depth placed, from _____ feet to _____ feet for each plug set.

1st plug 660' with 70 sacks

2nd plug 240' with 40 sacks

3rd plug 40' with 10 sacks

5 sacks for rat hole

Total 125 sacks 50/50 poz 4% gel 3% cc

RECEIVED
STATE CORPORATION COMMISSION
OCT 14 1981
10-14-81
CONSERVATION DIVISION
Wichita, Kansas

(If additional description is necessary, use BACK of this sheet)

Name of Plugging Contractor Lawbanco Drilling, Inc.
Box 289 Natoma, Kansas 67651

STATE OF Kansas COUNTY OF Osborne, ss.
R. L. Finnesy (employee of owner) or (owner or operator)


of the above-described well, being first duly sworn on oath, says: That I have knowledge of the facts, statements, and matters herein contained and the log of the above-described well as filed and that the same are true and correct. So help me God.

(Signature) R L Finnesy
2220 Marjorie Hays, Kansas 67601
(Address)

SUBSCRIBED AND SWORN TO before me this 13th day of October, 1981

My commission expires 4-20-85

Kathy Hachmeister
Kathy Hachmeister Notary Public.

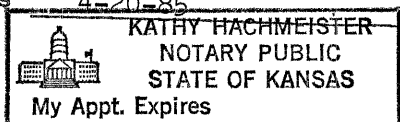

KANSAS

WELL COMPLETION REPORT AND
DRILLER'S LOG


API No. 15 - Osborne 141 - 20,120-00-06
County Number

S. 2 T. 10 R. 15 ^E/_W

Loc. NW NE NW

County Osborne

640 Acres
N

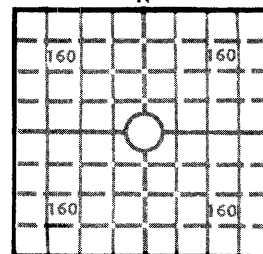

Locate well correctly

Elev. 1888

DF 1890 KB 1893

Operator
Lawbanco Drilling, Inc.

Address
Box 289 Natoma, Kansas 67651

Well No. 1 Lease Name Finnesy

Footage Location
feet from (N) (S) line _____ feet from (E) (W) line _____

Principal Contractor Lawbanco Drilling, Inc. Geologist John James

Spud Date 10-6-81 Date Completed 10-10-81 Total Depth 3200 P.B.T.D. _____

Directional Deviation _____ Oil and/or Gas Purchaser _____

CASING RECORD

Report of all strings set — surface, intermediate, production, etc.

Purpose of string	Size hole drilled	Size casing set (in O.D.)	Weight lbs/ft.	Setting depth	Type cement	Sacks	Type and percent additives
Surface	12 1/4	8 5/8	20	166	common	100	Quikset

LINER RECORD

PERFORATION RECORD

Top, ft.	Bottom, ft.	Sacks cement	Shots per ft.	Size & type	Depth interval

TUBING RECORD

Size	Setting depth	Packer set at

ACID, FRACTURE, SHOT, CEMENT SQUEEZE RECORD

Amount and kind of material used	Depth interval treated

INITIAL PRODUCTION

Date of first production _____ Producing method (flowing, pumping, gas lift, etc.) _____

RATE OF PRODUCTION PER 24 HOURS	Oil	Gas	Water	Gas-oil ratio
	bbls.	MCF	bbls.	CFPB

Disposition of gas (vented, used on lease or sold) _____ Producing interval(s) _____

INSTRUCTIONS: As provided in KCC Rule 82-2-125, within 90 days after completion of a well, one completed copy of this Drillers Log shall be transmitted to the State Geological Survey of Kansas, 4150 Monroe Street, Wichita, Kansas 67209. Copies of this form are available from the Conservation Division, State Corporation Commission, 245 No. Water, Wichita, Kansas 67202. Phone AC 316-522-2206. If confidential custody is desired, please note Rule 82-2-125. Drillers Logs will be on open file in the Oil and Gas Division, State Geological Survey of Kansas, Lawrence, Kansas 66044.

Operator Lawbanco Drilling, Inc. DESIGNATE TYPE OF COMP.: OIL, GAS, DRY HOLE, SWDW, ETC.: dry hole

Well No. 1 Lease Name Finnesy

S 2 T 10 R 15 W NW NE NW

WELL LOG

Show all important zones of porosity and contents thereof; cored intervals, and all drill-stem tests, including depth interval tested, cushion used, time tool open, flowing and shut-in pressures, and recoveries.

SHOW GEOLOGICAL MARKERS, LOGS RUN, OR OTHER DESCRIPTIVE INFORMATION.

FORMATION DESCRIPTION, CONTENTS, ETC.	TOP	BOTTOM	NAME	DEPTH
0 to 166 Shale and sand				
166 to 800 Sand and shale				
800 to 1109 Shale and sand				
1109 to 1143 Anhydrite				
1143 to 1793 Sand and shale				
1793 to 2330 Shale and shells				
2330 to 2835 Shale and lime				
2835 to 3010 Lime and shale				
3010 to 3200 Shale and shells	RTD			

RECEIVED
STATE CORPORATION COMMISSION
OCT 14 1981
10-14-81
CONSERVATION DIVISION
Wichita, Kansas

USE ADDITIONAL SHEETS, IF NECESSARY, TO COMPLETE WELL RECORD.

Date Received	<i>B. J. Finnesy</i>
	Drilling Superintendent
	October 13, 1981