

CARD MUST BE TYPED

State of Kansas  
**NOTICE OF INTENTION TO DRILL**  
(see rules on reverse side)

CARD MUST BE SIGNED

Starting Date: <sup>12</sup>12-17-84  
month day year

API Number 15- 207-25, 18L00-00

OPERATOR: License # 6538  
Name Gerald W. Keys Oil Production  
Address Rt 1 Box 179  
City/State/Zip Humboldt, KS 66748  
Contact Person Gerald W. Keys  
Phone 316-473-3340

E<sup>1</sup>/<sub>2</sub> SW<sup>1</sup>/<sub>4</sub> Sec 15 Twp 25 S, Rge 17  
(location)  East  West

1230 Ft North from Southeast Corner of Section  
3795 Ft West from Southeast Corner of Section  
(Note: Locate well on Section Plat on reverse side)

CONTRACTOR: License # 6538  
Name Gerald W. Keys Oil Production  
City/State Humboldt, KS

Nearest lease or unit boundary line 165 feet.

County Woodson

Lease Name Bill Collins Well# 2-"B"

Domestic well within 330 feet:  yes  no

Municipal well within one mile:  yes  no

Well Drilled For: Well Class: Type Equipment:  
XXOil  Swd  Infield XXMud Rotary  
 Gas  Inj XX Pool Ext.  Air Rotary  
 OWWO  Expl  Wildcat  Cable

Depth to Bottom of fresh water ..... feet

Lowest usable water formation Plattsburg lime

Depth to Bottom of usable water 200 feet

Surface pipe by Alternate: 1  2

Surface pipe to be set 20 feet

Conductor pipe if any required None feet

Ground surface elevation 965 feet MSL

This Authorization Expires 6-7-85

Approved By 12-7-84 R

If OWWO: old well info as follows:

Operator .....

Well Name .....

Comp Date ..... Old Total Depth .....

Projected Total Depth 900 feet

Projected Formation at TD Shale

Expected Producing Formations Squirrel


I certify that we will comply with K.S.A. 55-101, et seq., plus eventually plugging hole to K.C.C. specifications.

Date 12-6-84 Signature of Operator or Agent Gerald Keys Title Owner

Must be filed with the K.C.C. five (5) days prior to commencing well  
This card void if drilling not started within six (6) months of date received by K.C.C.

**Important procedures to follow :**

**A Regular Section of Land  
1 Mile = 5,280 Ft.**

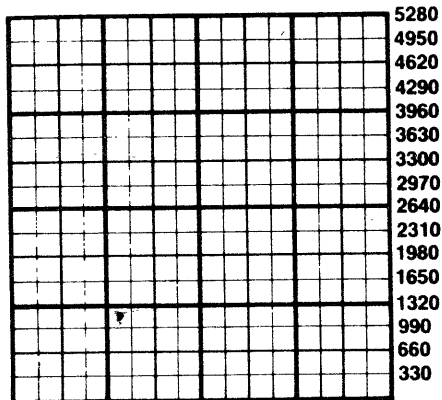

1. Notify District office before setting surface casing.
2. Set surface casing by circulating cement to the top.
3. File completion forms ACO-1 with K.C.C. within 90 days of well completion, following instructions on ACO-1, side 1, and including copies of wireline logs.
4. Notify District office 48 hours prior to old well workover or re-entry.
5. Prior to plugging, prepare a plugging plan, then obtain agreement from the appropriate district office for an approved plugging plan.
6. Submit plugging report (CP-4) to K.C.C. after plugging is completed.
7. Obtain an approved injection docket number before disposing of salt water.
8. Notify K.C.C. within 10 days when injection commences or terminates.
9. If an alternate 2 completion, cement in the production pipe from below any usable water to surface within 120 days of spud date.

RECEIVED

STATE CORPORATION COMMISSION

State Corporation Commission of Kansas  
Conservation Division  
200 Colorado Derby Building  
Wichita, Kansas 67202  
(316) 263-3238

DEC 07 1984

CONSERVATION DIVISION  
Wichita, Kansas

12-7-84