

CARD MUST BE TYPED

State of Kansas

CARD MUST BE SIGNED

### NOTICE OF INTENTION TO DRILL

(see rules on reverse side)

Expected Spud Date..... 5/1/87  
month day year

API Number 15- 207-25514-0000 ✓

OPERATOR: License # 6538  
Name Gerald Keys Prod. & Exploration Co  
Address Rte #1, P. O. Box 179  
City/State/Zip Humboldt, Ks 66748  
Contact Person Gerald Keys  
Phone (316) 473-3340

SW NW SW Sec. 15 Twp. 25 S, Rg. 17  East  
1530 Ft. from South Line of Section  
4750 Ft. from East Line of Section

(Note: Locate well on Section Plat on reverse side)

CONTRACTOR: License # 6745  
Name Donald G. Keys dba Auburn Drilling  
City/State Colony, Ks 66015

Nearest lease or unit boundary line 530 feet  
County Woodson

Lease Name Massoth Well # 9

Well Drilled For: Well Class: Type Equipment:  
 Oil  Storage  Infield  Mud Rotary  
 Gas  Inj  Pool Ext.  Air Rotary  
 OWWO  Expl  Wildcat  Cable

Ground surface elevation 1014 feet MSL

Domestic well within 330 feet:  yes  no

Municipal well within one mile:  yes  no

Depth to bottom of fresh water 40-200 feet

Depth to bottom of usable water 200 feet

Surface pipe by Alternate: 1  2

If OWWO: old well info as follows:  
Operator .....  
Well Name .....  
Comp Date ..... Old Total Depth.....

Surface pipe planned to be set 20 ft.

Conductor pipe required none

Projected Total Depth 820 feet

Formation Squirrel

I certify that well will comply with K.S.A. 55-101, et seq., plus eventually plugging hole to KCC specifications.  
Date 4/22/87 Signature of Operator or Agent Donald G. Keys Title Agent


For KCC Use:  
Conductor Pipe Required ..... feet; Minimum Surface Pipe Required 10 feet per Alt. # 2  
This Authorization Expires 10-27-87 Approved By [Signature] 4-27-87

Must be filed with the K.C.C. five (5) days prior to commencing well  
This card void if drilling not started within six (6) months of date received by K.C.C.

Important procedures to follow:

1. Notify District office before setting surface casing.
2. Set surface casing by circulating cement to the top.
3. File completion forms ACO-1 with K.C.C. within 120 days of well spud date, following instructions on ACO-1, side 1, and including copies of wireline logs.
4. Notify District office 48 hours prior to old well workover or re-entry. Prior to filing Intent, prepare a proposed plugging plan in case well is D & A, then obtain approval of plan when calling district office prior to setting surface pipe.
6. Submit plugging report (CP-4) to K.C.C. after plugging is completed.
7. Obtain an approved injection docket number before disposing of salt water.
8. Notify K.C.C. within 10 days when injection commences or terminates.
9. If an alternate 2 completion, cement in the production pipe from below any usable water to surface within 120 days of spud date.

A Regular Section of Land  
1 Mile = 5,280 Ft.

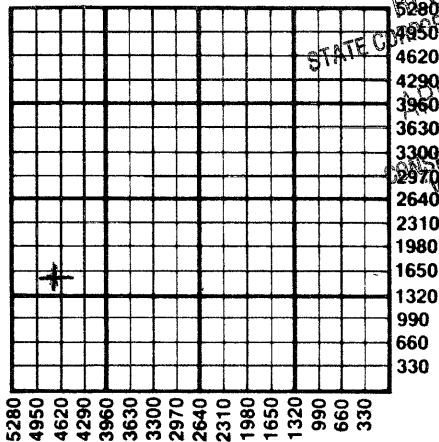

State Corporation Commission of Kansas  
Conservation Division  
200 Colorado Derby Building  
Wichita, Kansas 67202-1212  
(316) 263-3238