

CARD MUST BE TYPED

State of Kansas
NOTICE OF INTENTION TO DRILL
(see rules on reverse side)

CARD MUST BE SIGNED

Starting Date: 11-25-85
month day year

API Number 15- 207-25, 420-00-00

OPERATOR: License # 6538

SW¹/₄ ... Sec 16. Twp 25. S, Rge 17. East West

Name Gerald W. Keys Oil Production & Exploration (location)

Address Rt 1 Box 179

2075..... Ft North from Southeast Corner of Section

City/State/Zip Humboldt, KS 66748

4340..... Ft West from Southeast Corner of Section

Contact Person Gerald W. Keys

(Note: Locate well on Section Plat on reverse side)

Phone 316-473-3340

Nearest lease or unit boundary line 565..... feet.

CONTRACTOR: License # 6538

County Woodson

Name Gerald W. Keys Oil Production & Exploration

Lease Name Collins/Bennett #2 Well# 11

City/State Humboldt, KS

Domestic well within 330 feet : yes no

Municipal well within one mile : yes no

Well Drilled For: Well Class: Type Equipment:

- Oil Swd Infield Mud Rotary
- Gas Inj Pool Ext. Air Rotary
- OWWO Expl Wildcat Cable

Depth to Bottom of fresh water None..... feet

Lowest usable water formation Plattsville Lime

Depth to Bottom of usable water 200..... feet

Surface pipe by Alternate : 1 2

Surface pipe to be set 20..... feet

Conductor pipe if any required None..... feet

Ground surface elevation feet MSL

This Authorization Expires 5-20-86

Approved By 11-20-85 *[Signature]*

If OWWO: old well info as follows:

Operator

Well Name

Comp Date Old Total Depth

Projected Total Depth 875..... feet

Projected Formation at TD Shale

Expected Producing Formations Squirrel

I certify that we will comply with K.S.A. 55-101, et seq., plus eventually plugging hole to K.C.C. specifications.


Date NOV. 19-85 Signature of Operator or Agent

Gerald Keys Title owner operator

**Must be filed with the K.C.C. five (5) days prior to commencing well
This card void if drilling not started within six (6) months of date received by K.C.C.**

Important procedures to follow :

**A Regular Section of Land
1 Mile = 5,280 Ft.**

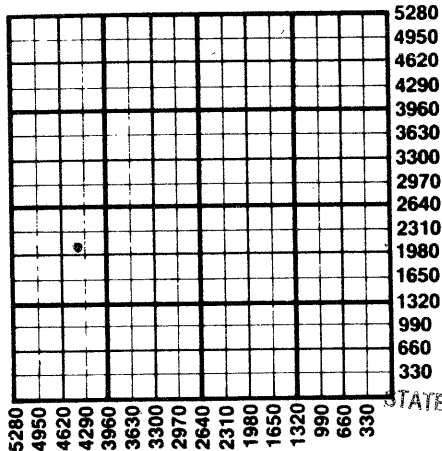

1. Notify District office before setting surface casing.
2. Set surface casing by circulating cement to the top.
3. File completion forms ACO-1 with K.C.C. within 90 days of well completion, following instructions on ACO-1, side 1, and including copies of wireline logs.
4. Notify District office 48 hours prior to old well workover or re-entry.
5. Prior to plugging, prepare a plugging plan, then obtain agreement from the appropriate district office for an approved plugging plan.
6. Submit plugging report (CP-4) to K.C.C. after plugging is completed.
7. Obtain an approved injection docket number before disposing of salt water.
8. Notify K.C.C. within 10 days when injection commences or terminates.
9. If an alternate 2 completion, cement in the production pipe from below any usable water to surface within 120 days of spud date.

RECEIVED
STATE CORPORATION COMMISSION

State Corporation Commission of Kansas
Conservation Division
200 Colorado Derby Building
Wichita, Kansas 67202
(316) 263-3238

NOV 20 1985

CONSERVATION DIVISION
Wichita, Kansas

1120-85