

CARD MUST BE TYPED

State of Kansas
NOTICE OF INTENTION TO DRILL
(see rules on reverse side)

CARD MUST BE SIGNED

Starting Date: January..... 5..... 1986.....
month day year

API Number 15- 207 - 25,442-00-00

OPERATOR: License # 6538.....
Name Gerald Keys Production and Exploration
Address Rte #1, Box 179
City/State/Zip Humboldt, Ks 66748
Contact Person Gerald Keys
Phone ...(316) 473-3340

.. NW $\frac{1}{4}$... SW $\frac{1}{4}$. Sec .16. Twp .25. S, Rge 17. . East
(location) West

... 1620 Ft North from Southeast Corner of Section
... 4680 Ft West from Southeast Corner of Section
(Note: Locate well on Section Plat on reverse side)

CONTRACTOR: License # ... 6745.....
Name .. Donald G. Keys dba Auburn Drilling
City/State Colony, Ks.....

Nearest lease or unit boundary line 600 feet.
County ... Woodson

Lease Name Collins Bennet. -2 Well# .14.....

Domestic well within 330 feet: yes no

Municipal well within one mile: yes no

Well Drilled For: **Well Class:** **Type Equipment:**
 Oil Swd Infield Mud Rotary
 Gas Inj Pool Ext. Air Rotary
 OWWO Expl Wildcat Cable

Depth to Bottom of fresh water 20 feet

Lowest usable water formation . Plattsburg Lime.....

Depth to Bottom of usable water 200 feet

Surface pipe by Alternate: 1 2

Surface pipe to be set 20 feet

Conductor pipe if any required none feet

Ground surface elevation 1010 feet MSL

This Authorization Expires 6-85-86

Approved By [Signature]

If OWWO: old well info as follows:

Operator

Well Name

Comp Date Old Total Depth

Projected Total Depth 860 feet

Projected Formation at TD Cherokee

Expected Producing Formations Squirrel


I certify that we will comply with K.S.A. 55-101, et seq., plus eventually plugging hole to K.C.C. specifications.

Date 12-26-85 Signature of Operator or Agent [Signature] Title Agent

Must be filed with the K.C.C. five (5) days prior to commencing well
This card void if drilling not started within six (6) months of date received by K.C.C.

Important procedures to follow :

**A Regular Section of Land
1 Mile = 5,280 Ft.**

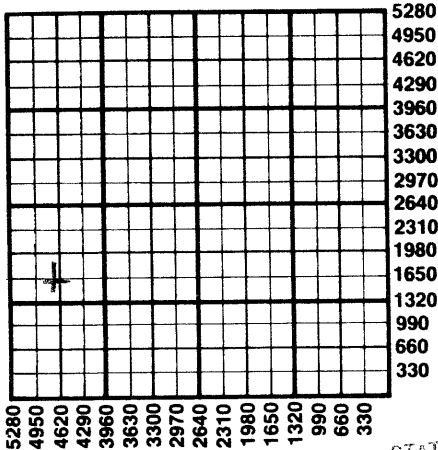

1. Notify District office before setting surface casing.
2. Set surface casing by circulating cement to the top.
3. File completion forms ACO-1 with K.C.C. within 90 days of well completion, following instructions on ACO-1, side 1, and including copies of wireline logs.
4. Notify District office 48 hours prior to old well workover or re-entry.
5. Prior to plugging, prepare a plugging plan, then obtain agreement from the appropriate district office for an approved plugging plan.
6. Submit plugging report (CP-4) to K.C.C. after plugging is completed.
7. Obtain an approved injection docket number before disposing of salt water.
8. Notify K.C.C. within 10 days when injection commences or terminates.
9. If an alternate 2 completion, cement in the production pipe from below any usable water to surface within 120 days of spud date.

STATE CORPORATION COMMISSION OF KANSAS

12-30-85
DEC 30 1985

CONSERVATION DIVISION
WICHITA, KANSAS

**State Corporation Commission of Kansas
Conservation Division
200 Colorado Derby Building
Wichita, Kansas 67202
(316) 263-3238**