

CARD MUST BE TYPED

State of Kansas

CARD MUST BE SIGNED

NOTICE OF INTENTION TO DRILL

(see rules on reverse side)

Starting Date Feb 10, 1987
month day year

API Number 15- 207-25,498-00-00

OPERATOR: License # 6538

NW NW SE Sec. 16 Twp. 25 S, Rg. 17 XX East

Name Gerald Keys Prod & Explor

2540 Ft. from South Line of Section

Address Rte. #1, Box 179

2540 Ft. from East Line of Section

City/State/Zip Humboldt, Ks 66748

(Note: Locate well on Section Plat on reverse side)

Contact Person Gerald Keys

Phone (316) 473-3340

CONTRACTOR: License # 6745

Name Donald G. Keys dba Auburn Drilling

City/State Colony, Ks

Well Drilled For: Well Class: Type Equipment:

Oil SWD Infield Mud Rotary
 Gas Inj Pool Ext. Air Rotary
 OWWO Expl Wildcat Cable

If OWWO: old well info as follows: Water Supply Well

Operator

Well Name

Comp Date Old Total Depth

I certify that well will comply with K.S.A. 55-101, et seq., plus eventually plugging hole to KCC specifications.

Date 1/21/87 Signature of Operator or Agent Gerald Keys Title operator

For KCC Use:

Conductor Pipe Required feet; Minimum Surface Pipe Required

This Authorization Expires 7-30-87

Nearest lease or unit boundary line 100 feet

County Woodson

Lease Name Collins-Bennet #3 Well # WS-1

Ground surface elevation 1008 feet MSL

Domestic well within 330 feet: yes no

Municipal well within one mile: yes no

Depth to bottom of fresh water ± 20

Depth to bottom of usable water 200

Surface pipe by Alternate: 1 2

Surface pipe planned to be set 20

Conductor pipe required none

Projected Total Depth 400 feet

Formation Kansas City Lime


Approved By 1-30-87 [Signature] (2)

Must be filed with the K.C.C. five (5) days prior to commencing well
This card void if drilling not started within six (6) months of date received by K.C.C.

Important procedures to follow:

1. Notify District office before setting surface casing.
2. Set surface casing by circulating cement to the top.
3. File completion forms ACO-1 with K.C.C. within 90 days of well completion, following instructions on ACO-1, side 1, and including copies of wireline logs.
4. Notify District office 48 hours prior to old well workover or re-entry.
5. Prior to filing Intent, prepare a proposed plugging plan in case well is D & A, then obtain approval of plan when calling district office prior to setting surface pipe.
6. Submit plugging report (CP-4) to K.C.C. after plugging is completed.
7. Obtain an approved injection docket number before disposing of salt water.
8. Notify K.C.C. within 10 days when injection commences or terminates.
9. If an alternate 2 completion, cement in the production pipe from below any usable water to surface within 120 days of spud date.

**A Regular Section of Land
1 Mile = 5,280 Ft.**

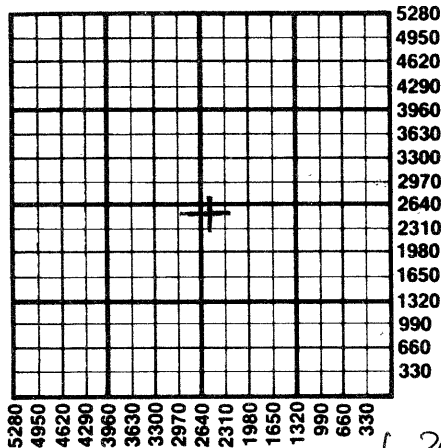

STATE CORPORATION COMMISSION STATE CORPORATION COMMISSION

JAN 30 1987

JAN 28 1987

CONSERVATION DIVISION
Wichita, Kansas

CONSERVATION DIVISION
Wichita, Kansas

State Corporation Commission of Kansas
Conservation Division
200 Colorado Derby Building
Wichita, Kansas 67202
(316) 263-3238