

CARD MUST BE TYPED

State of Kansas

CARD MUST BE SIGNED

# NOTICE OF INTENTION TO DRILL

(see rules on reverse side)

Expected Spud Date..... 6-4-87  
month day year

API Number 15-207-25,522-00-00

OPERATOR: License # 6538  
Name Gerald W. Keys Oil Production & Explor  
Address Rt 1 Box 179  
City/State/Zip Humboldt, KS 66748  
Contact Person Gerald W. Keys  
Phone 316-473-3340

NW<sup>1</sup>/<sub>4</sub> NE<sup>1</sup>/<sub>4</sub> SW<sup>1</sup>/<sub>4</sub> Sec. 16 Twp. 25 S, Rg. 17 East  
2440 Ft. from South Line of Section  
3840 Ft. from East Line of Section

(Note: Locate well on Section Plat on reverse side)

CONTRACTOR: License # 6538  
Name Gerald W. Keys Oil Production & Explor  
City/State Humboldt, KS 66748

Nearest lease or unit boundary line 200 feet  
County Woodson  
Lease Name Collins/Bennett #2 Well # 15

Well Drilled For: Well Class: Type Equipment:  
 Oil  Storage  Infield  Mud Rotary  
 Gas  Inj  Pool Ext.  Air Rotary  
 OWWO  Expl  Wildcat  Cable

Ground surface elevation feet MSL  
Domestic well within 330 feet:  yes  no  
Municipal well within one mile:  yes  no  
Depth to bottom of fresh water 20  
Depth to bottom of usable water 200  
Surface pipe by Alternate: 1  2   
Surface pipe planned to be set 22'  
Conductor pipe required None  
Projected Total Depth 860 feet  
Formation Squirrel

If OWWO: old well info as follows:

Operator  
Well Name  
Comp Date Old Total Depth

I certify that well will comply with K.S.A. 55-101, et seq, plus eventually plugging hole to KCC specifications.

Date 5-28-87 Signature of Operator or Agent Gerald W. Keys Title operator

For KCC Use:


Conductor Pipe Required feet; Minimum Surface Pipe Required 20 feet per Alt.  
This Authorization Expires 11-29-87 Approved By 5-29-87

Must be filed with the K.C.C. five (5) days prior to commencing well  
 This card void if drilling not started within six (6) months of date received by K.C.C.

**Important procedures to follow:**

1. Notify District office before setting surface casing.
  2. Set surface casing by circulating cement to the top.
  3. File completion forms ACO-1 with K.C.C. within 120 days of well spud date, following instructions on ACO-1, side 1, and including copies of wireline logs.
  4. Notify District office 48 hours prior to old well workover or re-entry.
  5. Prior to filing Intent, prepare a proposed plugging plan in case well is D & A, then obtain approval of plan when calling district office prior to setting surface pipe.
- Submit plugging report (CP-4) to K. C. C. after plugging is completed.
- Obtain an approved injection docket number before disposing of salt water.
- Notify K.C.C. within 10 days when injection commences or terminates.
9. If an alternate 2 completion, cement in the production pipe from below any usable water to surface within 120 days of spud date.

**A Regular Section of Land  
 1 Mile = 5,280 Ft.**

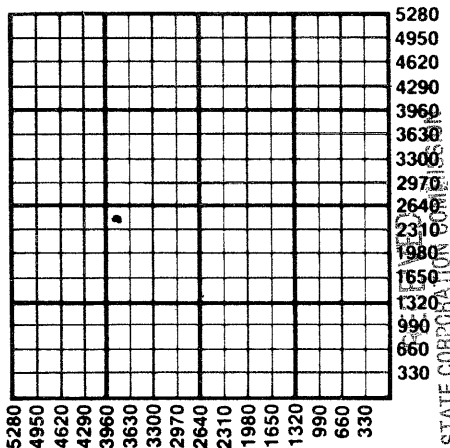

MAY 29 1964

CONSERVATION DIVISION  
 Wichita, Kansas

5-29-87

State Corporation Commission of Kansas  
 Conservation Division  
 200 Colorado Derby Building  
 Wichita, Kansas 67202-1212  
 (316) 263-3238