

CARD MUST BE TYPED

State of Kansas

CARD MUST BE SIGNED

NOTICE OF INTENTION TO DRILL

(see rules on reverse side)

Starting Date 2-10-87
month day year

API Number 15- 207-25,497-00-00

OPERATOR: License # 6538
Name Gerald W. Keys Oil Prod & Exploration
Address Rt 1 Box 179
City/State/Zip Humboldt, KS 66748
Contact Person Gerald W. Keys
Phone 316-473-3340

SE SE NE. Sec. 21. Twp. 25. S, Rg. 17. East
2840
120
Ft. from South Line of Section
Ft. from East Line of Section

(Note: Locate well on Section Plat on reverse side)

CONTRACTOR: License # 6538
Name Gerald W. Keys Oil Prod & Exploration
City/State Humboldt, KS 66748

Nearest lease or unit boundary line 200 feet
County Woodson

Lease Name Collins/Bennet #1 Well # WS-1
Ground surface elevation 1010 feet MSL

Well Drilled For: Well Class: Type Equipment:
___ Oil ___ SWD ___ Infield X Mud Rotary
___ Gas ___ Inj ___ Pool Ext. ___ Air Rotary
___ OWWO ___ Expl ___ Wildcat ___ Cable

Domestic well within 330 feet: ___yes Xno

Municipal well within one mile: ___yes Xno

Depth to bottom of fresh water ± 20

Depth to bottom of usable water 200

Surface pipe by Alternate: 1 ___ 2 X

If OWWO: old well info as follows: X*Water supply well**

Surface pipe planned to be set 25'

Conductor pipe required none

Projected Total Depth 400 feet

Formation Kansas City Lime

I certify that well will comply with K.S.A. 55-101, et seq., plus eventually plugging hole to KCC specifications.

Date 1-29-87 Signature of Operator or Agent *Gerald Keys* Title *Operator*

For KCC Use:

Conductor Pipe Required feet; Minimum Surface Pipe Required 20 feet per Alt. 2


This Authorization Expires 7-30-87 Approved By 1-30-87 *R*

Must be filed with the K.C.C. five (5) days prior to commencing well
This card void if drilling not started within six (6) months of date received by K.C.C.

Important procedures to follow:

1. Notify District office before setting surface casing.
2. Set surface casing by circulating cement to the top.
3. File completion forms ACO-1 with K.C.C. within 90 days of well completion, following instructions on ACO-1, side 1, and including copies of wireline logs.
4. Notify District office 48 hours prior to old well workover or re-entry.
5. Prior to filing Intent, prepare a proposed plugging plan in case well is D & A, then obtain approval of plan when calling district office prior to setting surface pipe.
6. Submit plugging report (CP-4) to K.C.C. after plugging is completed.
7. Obtain an approved injection docket number before disposing of salt water.
8. Notify K.C.C. within 10 days when injection commences or terminates.
9. If an alternate 2 completion, cement in the production pipe from below any usable water to surface within 120 days of spud date.

**A Regular Section of Land
1 Mile = 5,280 Ft.**

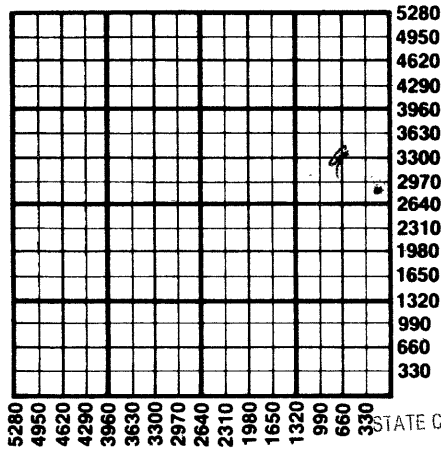

STATE CORPORATION COMMISSION

JAN 30 1987
CONSERVATION DIVISION
Wichita, Kansas

1-30-87

State Corporation Commission of Kansas
Conservation Division
200 Colorado Derby Building
Wichita, Kansas 67202
(316) 263-3238