

CARD MUST BE TYPED

State of Kansas

CARD MUST BE SIGNED

NOTICE OF INTENTION TO DRILL

(see rules on reverse side)

****CORRECTION****

Starting Date 10 24 85
month day year

API Number 15— 141,01,000 - 00 - 01 ¹⁰⁻¹⁵⁻⁸⁵

OPERATOR: License # 7030
Name .. John Roy Evans
Address ... 405 Fourth Street
City/State/Zip ... Claflin, Kansas ... 67525
Contact Person John Roy Evans
Phone 316/587-3565

_____ East
SE...SE...NE Sec. 2 Twp. 10... S, Rg. 15..... West
..... 2970 Ft. from South Line of Section
..... 330 Ft. from East Line of Section

(Note: Locate well on Section Plat on reverse side)

CONTRACTOR: License # 5929
Name .. Duke Drilling Co., Inc.
City/State .. Great Bend, Kansas ... 67530

Nearest lease or unit boundary line 330 feet
County .. Osborne

Well Drilled For: Well Class: Type Equipment:
 Oil SWD Infield Mud Rotary
 Gas Inj Pool Ext. Air Rotary
 OWWO Expl Wildcat Cable


**** Lease Name... Finnesy Well # ... 2
Ground surface elevation feet MSL

If OWWO: old well info as follows:

Operator ... D. R. Lauck & Whitestone Petroleum
Well Name Finnesy #1
Comp Date ... 10/2/63 Old Total Depth ... 3770

Domestic well within 330 feet: _____ yes no
Municipal well within one mile: _____ yes no
Surface pipe by Alternate: 1 _____ 2
Depth to bottom of fresh water 200
Depth to bottom of usable water 750
Surface pipe planned to be set 206
Projected Total Depth 3770 feet
Formation Arbuckle

I certify that well will comply with K.S.A. 55-101, et seq., plus eventually plugging hole to KCC specifications.

—XXX—  cementing will be done immediately upon setting production casing.

WAS: FINNESY #1

Date Signature of Operator or Agent Sally R Byers Title.. Agent

For KCC Use:

Sally R Byers

Conductor Pipe Required feet; Minimum Surface Pipe Required feet per Alt. 1 2


This Authorization Expires 4-8-86 Approved By 10-8-85

Must be filed with the K.C.C. five (5) days prior to commencing well
This card void if drilling not started within six (6) months of date received by K.C.C.

Important procedures to follow:

1. Notify District office before setting surface casing.
2. Set surface casing by circulating cement to the top.
3. File completion forms ACO-1 with K.C.C. within 90 days of well completion, following instructions on ACO-1, side 1, and including copies of wireline logs.
4. Notify District office 48 hours prior to old well workover or re-entry.
5. Prior to filing Intent, prepare a proposed plugging plan in case well is D & A, then obtain approval of plan when calling district office prior to setting surface pipe.
6. Submit plugging report (CP-4) to K.C.C. after plugging is completed.
7. Obtain an approved injection docket number before disposing of salt water.
8. Notify K.C.C. within 10 days when injection commences or terminates.
9. If an alternate 2 completion, cement in the production pipe from below any usable water to surface within 120 days of spud date.

A Regular Section of Land
1 Mile = 5,280 Ft.

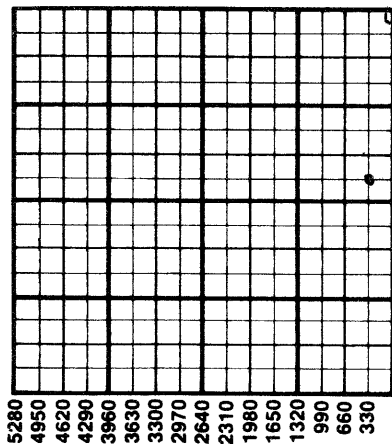

RECEIVED
STATE CORPORATION COMMISSION

OCT 15 1985
10-15-85

CONSERVATION DIVISION
Wichita, Kansas

State Corporation Commission of Kansas
Conservation Division
200 Colorado Derby Building
Wichita, Kansas 67202
(316) 263-3238