

STATE OF KANSAS
STATE CORPORATION COMMISSION

Give All Information Completely
Make Required Affidavit
Mail or Deliver Report to:
Conservation Division
State Corporation Commission
800 Bitting Building
Wichita, Kansas

WELL PLUGGING RECORD

Osborne County. Sec. 22 Twp. 10S Rge. 13W (E) (W)

Location as "NE/CNW $\frac{1}{4}$ /SW $\frac{1}{4}$ " or footage from lines NE NE SE

Lease Owner A. D. Allison et al

Lease Name Finkenbinder Well No. 1

Office Address 715 Brown Building, Wichita 2, Kansas

Character of Well (completed as Oil, Gas or Dry Hole) Dry Hole

Date well completed 5-25-1951

Application for plugging filed 19

Application for plugging approved 19


Plugging commenced 19

Plugging completed 19

Reason for abandonment of well or producing formation Dry Hole

If a producing well is abandoned, date of last production 19

Was permission obtained from the Conservation Division or its agents before plugging was commenced? Yes

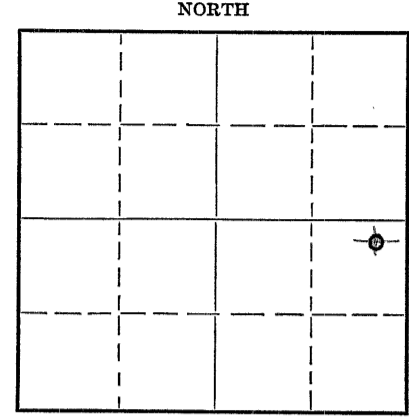

Locate well correctly on above Section Plat

Name of Conservation Agent who supervised plugging of this well Eldon Petty

Producing formation Depth to top Bottom Total Depth of Well 3930 Feet

Show depth and thickness of all water, oil and gas formations.

OIL, GAS OR WATER RECORDS

CASING RECORD

Formation	Content	From	To	Size	Put In	Pulled Out
				8-5/8	200'	

Describe in detail the manner in which the well was plugged, indicating where the mud fluid was placed and the method or methods used in introducing it into the hole. If cement or other plugs were used, state the character of same and depth placed, from feet to feet for each plug set.

Set bottom plug at 190' - cemented with 15 sacks through drill pipe.
Set top plug at 40' - cemented with 10 sacks cement and 1/2 sack hulls.

(If additional description is necessary, use BACK of this sheet)

Correspondence regarding this well should be addressed to A. D. Allison & Co., Inc.,
Address 715 Brown Building, Wichita 2, Kansas.

STATE OF Kansas COUNTY OF Sedgwick ss.
J. A. ALLISON (employee of owner) or (owner or operator) of the above-described well,

being first duly sworn on oath, says: That I have knowledge of the facts, statements, and matters herein contained and the log of the above-described well as filed and that the same are true and correct. So help me God.

(Signature) J. A. Allison
715 Brown Building, Wichita 2, Kansas
(Address)

SUBSCRIBED AND SWORN to before me this 29th day of May, 1951

My commission expires 7-22-53

Notary Public

PLUGGING
FILE SEC 22 T 10 R 13W
BOOK PAGE 5 LINE 3

STATE CORPORATION COMMISSION
5-31-51
MAY 31 1951
CONSERVATION DIVISION
Wichita, Kansas

15-141-00034-00-00

A. D. ALLISON ET AL
#1 FINKENBINDER

Sec. 22, Twp. 10S., Rge. 13W.,
Osborne County, Kansas.

Total Depth 3930'
Comm: 5-1-51
Comp: 5-25-51

NE NE SE
Elevation: 1734 D. F.

CONTR. A. D. ALLISON & CO., INC.,

D & A

CASING RECORD:

8-5/8 200'

<u>FORMATION</u>	<u>DEPTH</u>
Sand and shale	300
Shale	490
Shale, iron and lime	505
Shale and shells	760
Red bed	815
Anhydrite	850
Shale and shells	1520
Shale and soft lime	1600
Lime and shale	1690
Lime	1760
Lime and shale	1915
Lime	1970
Lime and shale	2000
Shale	2040
Shale and lime	2105
Lime and shale	2250
Shale	2530
Shale and lime	2615
Shale and shells	2755
Shale and lime	2830
Lime	2875
Lime and shale	2995
Lime	3175
Lime and shale	3185
Lime	3245
Lime and shale	3260
Lime	3300
Shale and lime	3320
Lime and shale	3575
Shale and chert	3615
Chert	3645
Shale, lime and chert	3670
Lime and shale	3750
Lime and chert	3795
Lime, Arbuckle	3930 - TD

TOPS:

Topeka lime	2670
Heebner shale	2960
Lansing-Kansas City	3020
Base KC Lime	3283
Viola	3571
Simpson	3694
Arbuckle Dol.	3742

Certified true copy of drillers log.

By _____

PLUGGING
 FILE SEC 22 10 13W
 BOOK PAGE 85 LINE 3

RECEIVED
 STATE CORPORATION
 MAY 22 1951
 OSBORNE COUNTY, KANSAS