


STATE OF KANSAS
STATE CORPORATION COMMISSION

WELL PLUGGING RECORD

Give All Information Completely
Make Required Affidavit
Mail or Deliver Report to:
Conservation Division
State Corporation Commission
800 Bitting Building
Wichita, Kansas

Osborne County. Sec. 10 Twp 10S Rge. 15 02 (W)
Location as "NE/CNW/SW" or footage from lines SE/4 NE/4 NE/4
Lease Owner Walters Drilling Co., Inc.
Lease Name H. C. Meyer Well No. 1
Office Address 510 Orpheum Building, Wichita, Kansas
Character of Well (completed as Oil, Gas or Dry Hole) Dry Hole
Date well completed May 9, 19 52
Application for plugging filed (verbal) May 9, 19 52
Application for plugging approved (verbal) May 10, 19 52
Plugging commenced May 10, 19 52
Plugging completed May 10, 19 52
Reason for abandonment of well or producing formation Dry Hole

NORTH

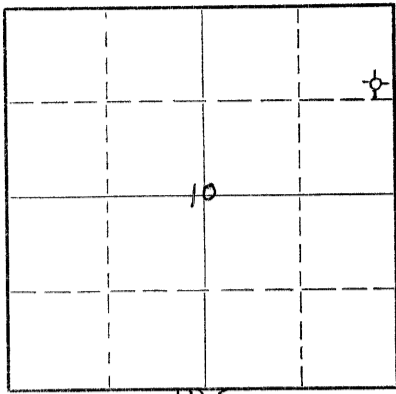

Locate well correctly on above
Section Plat

If a producing well is abandoned, date of last production _____ 19____
Was permission obtained from the Conservation Division or its agents before plugging was commenced? yes

Name of Conservation Agent who supervised plugging of this well C. D. Stough, Great Bend, Kansas
Producing formation None Depth to top _____ Bottom _____ Total Depth of Well 3862 Feet
Show depth and thickness of all water, oil and gas formations.

OIL, GAS OR WATER RECORDS

CASING RECORD

FORMATION	CONTENT	FROM	TO	SIZE	PUT IN	PULLED OUT
None	None	0	220'	8 5/8"	220'	None
	Cemented with 115 sacks cement					
	No oil string run - dry and abandoned					

Describe in detail the manner in which the well was plugged, indicating where the mud fluid was placed and the method or methods used in introducing it into the hole. If cement or other plugs were used, state the character of same and depth placed, from _____ feet to _____ feet for each plug set.

Set bottom plug at 210' with 20 sacks cement and 1/2 sack Hulls.

Set top plug at 40' with 10 sacks cement.

5-15-52

(If additional description is necessary, use BACK of this sheet)
Name of Plugging Contractor Walters Drilling Co., Inc.
Address 510 Orpheum Building, Wichita, Kansas

STATE OF KANSAS, COUNTY OF KANSAS, ss.
ROBERT F. WALTERS (employee of owner) or ~~(owner or operator)~~ of the above-described well, being first duly sworn on oath, says: That I have knowledge of the facts, statements, and matters herein contained and the log of the above-described well as filed and that the same are true and correct. So help me God.


(Signature) Robert F. Walters

(Address) _____

SUBSCRIBED AND SWORN TO before me this 14th day of May, 19 52

Pauline Hendrickson
Notary Public.

My commission expires March 10, 1956.

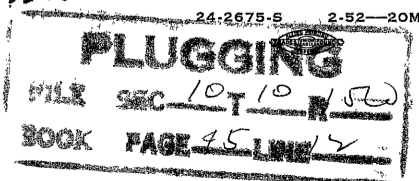

MEYER WELL NO. 1

Location: SE NE NE Sec. 10-10S-15W
Osborne County, Kansas

Date Spudded: 4-28-52

Operator: Walters Drilling Co., Inc.

Rotary Completion: 5-9-52

Contractor: Walters Drilling Co., Inc.

Elevation: 1994 Gr.
1996 DF
1998 KB

Surface Casing: 8 5/8" set at 220' with
115 sacks cement and
1 sack Cal. Chloride

Oil String: None - D & A

L O G

(Figures indicate bottom of formation)

Surface	0 to 220
Shale, lime, sand, shells	822
Sand and shale	1322
Shale and shells	2198
Shale	2305
Shale and lime	3619
Shale, lime and sand	3684
Sandy lime and shale	3738
Lime and Shale	3784
Lime, shale, chert	3833
Cherty lime and shale	3862
Total Depth (Rotary)	3862

The undersigned, Robert F. Walters, hereby certifies that the above log is a true and correct log of the formations encountered in drilling the above noted well as reflected by the Daily Drilling Reports.

WALTERS DRILLING CO., INC.

By Robert F. Walters

Subscribed and sworn to before me
this 14th day of May, 1952

Charles R. Hudson
Notary Public

5-15-52
CONSERVATION DIVISION
Wichita, Kansas

My commission expires March 10, 1956.

