

CARD MUST BE TYPED

State of Kansas  
**NOTICE OF INTENTION TO DRILL**  
(see rules on reverse side)

CARD MUST BE SIGNED

Starting Date: Sept. 12, 1984  
month day year

API Number 15- 207-25,033-0000

OPERATOR: License # 5963

SESE NE Sec 34 Twp 25 S, Rge 17  East  West  
(location)

Name Willis Energy

Address Rt. 2, Box 255

City/State/Zip Neodesha, Ks. 66757

Contact Person B. Willis

Phone 316-325-5189

2800 Ft North from Southeast Corner of Section

650 Ft West from Southeast Corner of Section

(Note: Locate well on Section Plat on reverse side)

CONTRACTOR: License # 9416

Nearest lease or unit boundary line 650 feet.

Name Gardwell Drilling

County Woodson

City/State Rt. 2, Erie, Ks. 66733

Lease Name Sharp Well# 1

Domestic well within 330 feet:  yes  no

Municipal well within one mile:  yes  no

Well Drilled For: Well Class: Type Equipment:

- Oil  Swd  Infield  Mud Rotary
- Gas  Inj  Pool Ext.  Air Rotary
- OWWO  Expl  Wildcat  Cable

Depth to Bottom of fresh water none feet

Lowest usable water formation none

Depth to Bottom of usable water none 200 feet

If OWWO: old well info as follows:

Operator .....

Well Name .....

Comp Date ..... Old Total Depth .....

Projected Total Depth 950 feet

Projected Formation at TD 900

Expected Producing Formations Bartlesville

Surface pipe by Alternate: 1  2

Surface pipe to be set 30 feet

Conductor pipe if any required ..... feet

Ground surface elevation ..... feet MSL

This Authorization Expires 3-7-85

Approved By 9-7-84 RC

I certify that we will comply with K.S.A. 55-101, et seq., plus eventually plugging hole to K.C.C. specifications.

Date Sept 6, 1984 Signature of Operator or Agent [Signature]


Title Operator

MHC/PHONE 9/7/84

**Must be filed with the K.C.C. five (5) days prior to commencing well  
This card void if drilling not started within six (6) months of date received by K.C.C.**

**Important procedures to follow :**

**A Regular Section of Land  
1 Mile = 5,280 Ft.**

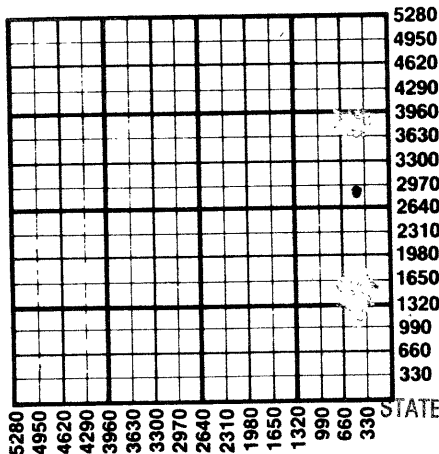

1. Notify District office before setting surface casing.
2. Set surface casing by circulating cement to the top.
3. File completion forms ACO-1 with K.C.C. within 90 days of well completion, following instructions on ACO-1, side 1, and including copies of wireline logs.
4. Notify District office 48 hours prior to old well workover or re-entry.
5. Prior to plugging, prepare a plugging plan, then obtain agreement from the appropriate district office for an approved plugging plan.
6. Submit plugging report (CP-4) to K.C.C. after plugging is completed.
7. Obtain an approved injection docket number before disposing of salt water.
8. Notify K.C.C. within 10 days when injection commences or terminates.
9. If an alternate 2 completion, cement in the production pipe from below any usable water to surface within 120 days of spud date.

RECEIVED

STATE CORPORATION COMMISSION

97-84

SEP 07 1984

CONSERVATION DIVISION  
Wichita, Kansas

State Corporation Commission of Kansas  
Conservation Division  
200 Colorado Derby Building  
Wichita, Kansas 67202  
(316) 263-3238