

CARD MUST BE TYPED

State of Kansas

CARD MUST BE SIGNED

NOTICE OF INTENTION TO DRILL

(see rules on reverse side)

Expected Spud Date: JUNE 22, 1987
month day year

OPERATOR: License # #5963
Name Willis Energy
Address Route 2, Box 255
Neodesha, KS 66757
City/State/Zip
Contact Person William E. Willis
Phone (316) 325-5189
5379

CONTRACTOR: License #
Name Kephart Drilling
Address Route 1, Box 68-A, Thayer, KS
City/State

Well Drilled For:	Well Class:	Type Equipment:
<input type="checkbox"/> Oil	<input checked="" type="checkbox"/> Infield	<input type="checkbox"/> Mud Rotary
<input checked="" type="checkbox"/> Gas	<input type="checkbox"/> Pool Ext.	<input checked="" type="checkbox"/> Air Rotary
<input type="checkbox"/> OWWO	<input type="checkbox"/> Wildcat	<input type="checkbox"/> Cable
<input type="checkbox"/> Storage	<input type="checkbox"/> Inj	

If OWWO: old well info as follows:

Operator
Well Name
Comp Date Old Total Depth

I certify that well will comply with K.S.A. 55-101, et seq., plus eventually plugging hole to KCC specifications.

Date 6-22-87 Signature of Operator or Agent [Signature] Title AS AGENT

For KCC Use:

Conductor Pipe Required feet; Minimum Surface Pipe Required 20 feet per Alt. XO

This Authorization Expires 12-22-87 Approved By [Signature] 6-22-87

API Number 15— 207-25,523-0000
C E/2 E/2 NW Sec 34 Twp. 25 S, Rg. 17 East
3960 Ft. from South Line of Section
2780 Ft. from East Line of Section

(Note: Locate well on Section Plat on reverse side)

Nearest lease or unit boundary line 330 feet
County Woodson
Lease Name White Well # 9

Ground surface elevation feet MSL
66776
Domestic well within 330 feet: yes no

Municipal well within one mile: yes no

Depth to bottom of fresh water 95
Depth to bottom of usable water 200

Surface pipe by Alternate: 30 1 2

Surface pipe planned to be set

Conductor pipe required

Projected Total Depth 900 feet


Formation Bartlesville

Must be filed with the K.C.C. five (5) days prior to commencing well
This card void if drilling not started within six (6) months of date received by K.C.C.

Important procedures to follow:

1. Notify District office before setting surface casing.
2. Set surface casing by circulating cement to the top.
3. File completion forms ACO-1 with K.C.C. within 120 days of well spud date, following instructions on ACO-1, side 1, and including copies of wireline logs.
4. Notify District office 48 hours prior to old well workover or re-entry.
5. Prior to filing Intent, prepare a proposed plugging plan in case well is D & A, then obtain approval of plan when calling district office prior to setting surface pipe.
6. Submit plugging report (CP-4) to K.C.C. after plugging is completed.
7. Obtain an approved injection docket number before disposing of salt water.
8. Notify K.C.C. within 10 days when injection commences or terminates.
9. If an alternate 2 completion, cement in the production pipe from below any usable water to surface within 120 days of spud date.

A Regular Section of Land 1 Mile = 5,280 Ft.

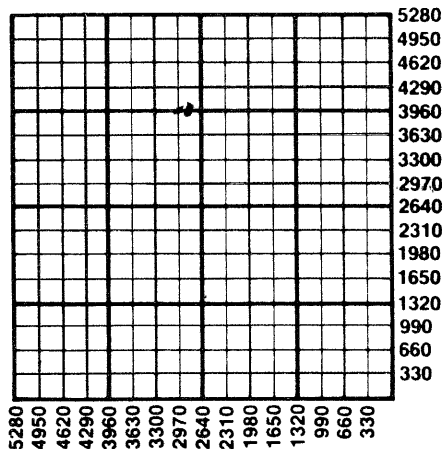

6-22-87

State Corporation Commission of Kansas
Conservation Division
200 Colorado Derby Building
Wichita, Kansas 67202-1212
(316) 263-3238

RECEIVED
STATE CORPORATION COMMISSION
WICHITA, KANSAS
JUN 23 1987