


15-141-00047-00-00

STATE OF KANSAS
STATE CORPORATION COMMISSION

Give All Information Completely
Make Required Affidavit
Mail or Deliver Report to:
Conservation Division
State Corporation Commission
211 No. Broadway
Wichita, Kansas

WELL PLUGGING RECORD

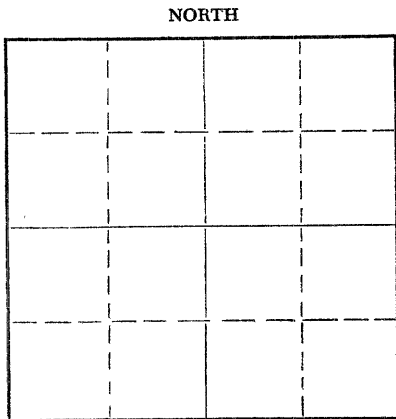

Locate well correctly on above
Section Plat

Osborne County. Sec. 14 Twp. 19 Rge. 15 (E) X (W)
Location as "NE/CNW/SW" or footage from lines NE NE SW
Lease Owner Jones, Shelburne & Farmer, Inc.
Lease Name Isenberg Well No. #1
Office Address 370 West Wichita Avenue, Russell, Kansas
Character of Well (completed as Oil, Gas or Dry Hole) Dry Hole
Date well completed 9-12 19 57
Application for plugging filed 9-12 19 57
Application for plugging approved 9-12 19 57
Plugging commenced 9-12 19 57
Plugging completed 9-12 19 57
Reason for abandonment of well or producing formation Dry Hole

If a producing well is abandoned, date of last production 19
Was permission obtained from the Conservation Division or its agents before plugging was commenced? Yes

Name of Conservation Agent who supervised plugging of this well Milton Galyardt
Producing formation Depth to top Bottom Total Depth of Well 3655 Feet
Show depth and thickness of all water, oil and gas formations.

OIL, GAS OR WATER RECORDS

CASING RECORD

FORMATION	CONTENT	FROM	TO	SIZE	PUT IN	PULLED OUT
				8 5/8	294	None

Describe in detail the manner in which the well was plugged, indicating where the mud fluid was placed and the method or methods used in introducing it into the hole. If cement or other plugs were used, state the character of same and depth placed, from feet to feet for each plug set.

Filled hole with heavy mud. First plug at 220' with rock bridge 20 sacks cement. Filled hole up to 40', 2nd plug, 1/2 sacks hulls, then plug and 10 sacks cement.

(If additional description is necessary, use BACK of this sheet)

Name of Plugging Contractor Jones, Shelburne & Farmer, Inc.
Address Russell, Kansas

STATE OF Kansas, COUNTY OF Russell, ss.
John O. Farmer (employee of owner) or (owner or operator) of the above-described well, being first duly sworn on oath, says: That I have knowledge of the facts, statements, and matters herein contained and the log of the above-described well as filed and that the same are true and correct. So help me God.

(Signature) John O. Farmer
370 West Wichita Avenue, Russell, Kansas
(Address)

SUBSCRIBED AND SWORN TO before me this 13th day of September, 19 57

My commission expires 4-5-1961

Jewel Holt
Notary Public.

PLUGGING
FILE SEC. 14 T. 10 R. 15 W
BOOK PAGE 45 LINE 32


9-19-57

OPERATOR Jones, Shelburne & Farmer, Inc.

FORMATION RECORD

ADDRESS Russell, Kansas

Give detailed description and thickness of all formation drilled through, contents of sand, whether dry, water, oil or gas.

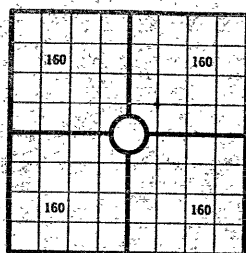640 Acres
N

Locate well correctly

COUNTY Osborne, SEC. 14, TWP. 10, RGE. 15COMPANY OPERATING Jones, Shelburne & Farmer, Inc.OFFICE ADDRESS Russell, KansasDRILLING STARTED 9/2, 1957 DRILLING FINISHED 9/18, 1957

DATE OF FIRST PRODUCTION _____ COMPLETED _____

WELL LOCATED NE 1/4 NE 1/4 SW 1/4, North of South

Line and _____ ft. East of West Line of Quarter Section

Elevation (Relative to sea level) DERRICK FLOOR 1945 GROUND 1945CHARACTER OF WELL (Oil, gas or dryhole) Dry hole.

OIL OR GAS SANDS OR ZONES

Name	From	To	Name	From	To
1			4		
2			5		
3			6		

Perforating Record if Any

Shot Record

Formation	From	To	No. of Shots	Formation	From	To	Size of Shot

CASING RECORD

Amount Set				Amount Pulled				Packer Record			
Size	Wt.	Thds.	Make	Ft.	In.	Ft.	In.	Size	Length	Depth Set	Make
8	5/8			294							

Liner Record: Amount _____ Kind _____ Top _____ Bottom _____

CEMENTING AND MUDDING

Size	Amount Set		Sacks Cement	Chemical		Method of Cementing	Amount	Mudding Method	Results (See Note)
	Ft.	In.		Gal.	Make				
8	5/8	294	150						

Note: What method was used to protect sands if outer strings were pulled?

NOTE: Were bottom hole plugs used? _____ If so, state kind, depth set and results obtained _____

TOOLS USED

Rotary Tools were used from _____ feet to _____ Cable tools were used from _____ feet to _____ feet, and from _____ feet to _____ feet, and from _____ feet to _____ feet to _____

Type Rig _____

INITIAL PRODUCTION TEST

Describe initial test, whether by flow through tubing or casing or by pumping _____

Amount of Oil Production _____ bbls. Size of choke, if any _____ Length of test _____ Water

Production _____ bbls. Gravity of oil _____ Type of Pump if pump is used, describe _____

I, the undersigned, being first duly sworn upon oath, state that this well record is true, correct and complete according to the records of this office and to the best of my knowledge and belief.

John W. Farmer
 Name and title of representative of company

Subscribed and sworn to before me this 16th day of September, 1957My Commission expires 4-5-1961

Jewel Helt
 Notary Public.

Formation	Top	Bottom	Formation	Top	Bottom
Shale	0	295	PLUGGING FILE SEC. T R BOOK PAGE LINE		
Shale	295	460			
Sand	460	525			
Shale	525	606			
Shale & Pyrite	606	615			
Sand	615	712			
Pyrite, Shale and Sand	712	745			
Shale & Sand	745	895			
Red Bed	895	1153			
Anhydrite	1153	1193			
Shale & Shells	1193	1750			
Lime & Shale	1750	3519			
Conglomerate	3519	3535			
Lime & Shale	3535	3647			
Arbuckle	3647	3655			
Total Depth	3655		TOPS:		
			Elevation	1945	R.B.
			Anhydrite	1153	
			Heebner	3086	
			Lansing	3136	
			B. K. C.	3406	
			Cong. Sand	3518	
			Cherty Cong.	3536	
			Simpson	3611	
			Arbuckle	3646	
			Total Depth	3655	
			D. & A.		

15-141-00047-000

FARM NAME Isenberg WELL NO. #1 COUNTY Osborne SEC. 14 TWP. 10 RGE. 15