

15-105-20009-00-00

STATE OF KANSAS  
STATE CORPORATION COMMISSION

WELL PLUGGING RECORD

Give All Information Completely  
Make Required Affidavit  
Mail or Deliver Report to  
Conservation Division  
State Corporation Comm.  
245 North Water  
Wichita, KS 67202

Lincoln County, Sec. 23 Twp. 10S Rge. 10W E/W  
Location as "NE/CNW $\frac{1}{4}$ SW $\frac{1}{4}$ " or footage from lines  
C SW/4 SE/4


Lease Owner Terra Resources, Inc.  
Lease Name Oetting Well No. 1  
Office Address P. O. Box 839, Oklahoma City, Oklahoma 73101  
Character of Well (Completed as Oil, Gas or Dry Hole) \_\_\_\_\_  
D & A

Date Well completed December 17, 1978  
Application for plugging filed December 17, 1978  
Application for plugging approved December 17, 1978  
Plugging commenced December 17, 1978  
Plugging completed December 17, 1978  
Reason for abandonment of well or producing formation \_\_\_\_\_  
D & A

If a producing well is abandoned, date of last production 19 \_\_\_\_\_

Was permission obtained from the Conservation Division or its agents before plugging was commenced? Yes

Name of Conservation Agent who supervised plugging of this well Gilbert Toman  
Producing formation \_\_\_\_\_ Depth to top \_\_\_\_\_ Bottom \_\_\_\_\_ Total Depth of Well 3,905'  
Show depth and thickness of all water, oil and gas formations.

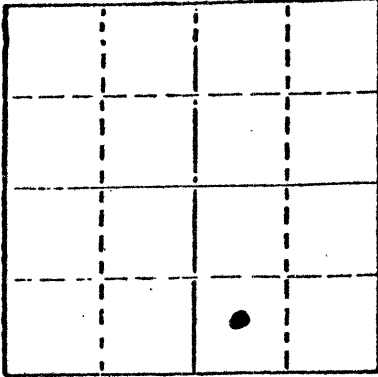

Locate well correctly on above Section Plat

OIL, GAS OR WATER RECORDS

CASING RECORD

| FORMATION | CONTENT | FROM | TO | SIZE   | PUT IN  | PULLED OUT |
|-----------|---------|------|----|--------|---------|------------|
|           |         |      |    | 8 5/8" | 438.80' | -0-        |
|           |         |      |    |        |         |            |
|           |         |      |    |        |         |            |
|           |         |      |    |        |         |            |

Describe in detail the manner in which the well was plugged, indicating where the mud fluid was placed and the method or methods used in introducing it into the hold. If cement or other plugs were used, state the character of same and depth placed, from \_\_\_\_\_ feet to \_\_\_\_\_ feet for each plug set.

Hole plugged w/50 sx cement @ 450'  
1/2 sx hulls & plug @ 40' w/10 sx cement to surface  
Plugged rathole

RECEIVED  
STATE CORPORATION COMMISSION

DEC 26 1978

12-261978  
CONSERVATION DIVISION

(If additional description is necessary, use BACK of this sheet)

Name of Plugging Contractor Red Tiger Drilling Company  
1720 KSB&T Building, Wichita, Kansas 67202


STATE OF Kansas COUNTY OF Sedgwick, ss. contractor  
Gloria Fawcett (employee of ~~xxxxxx~~)  
of the above-described well, being first duly sworn on oath, says: That I have knowledge of the facts, statements, and matters herein contained and the log of the above-described well as filed and that the same are true and correct. So help me God.

(Signature) Gloria Fawcett  
1720 KSB&T Building, Wichita, Kansas 67202  
(Address)

SUBSCRIBED AND SWORN TO before me this 19th day of December, 1978.

Joyce A. Hagermann  
Notary Public.

My commission expires \_\_\_\_\_

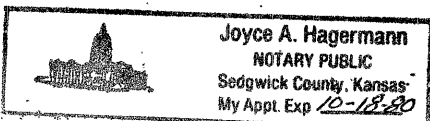

15-105-20009-00-00

DRILLERS LOG

No. 1 Oetting

RECEIVED  
DEC 21 1978  
TERRA RESOURCES, INC.

CASING RECORD:  
8 5/8" @ 448'  
w/300 sx cement

COMPANY: Terra Resources, Inc.  
CONTRACTOR: Red Tiger Drilling Company  
COMMENCED: November 29, 1978  
COMPLETED: December 17, 1978

DESCRIPTION:  
C SW/4 SE/4  
Sec. 23-T10S-R10W  
Lincoln County, Kansas

TOTAL DEPTH: 3,905'

ELEVATION:

| FORMATION                         | FROM | TO   | REMARKS |
|-----------------------------------|------|------|---------|
| Clay, Post Rock, Hard Sand & Sand | 0    | 180  |         |
| Hard Sand                         | 180  | 230  |         |
| Sand & Shale                      | 230  | 354  |         |
| Hard Sand & Chert                 | 354  | 380  |         |
| Shale & Iron Pyrite               | 380  | 470  |         |
| Shale                             | 470  | 1050 |         |
| Shale & Lime                      | 1050 | 1556 |         |
| Lime & Shale                      | 1556 | 2390 |         |
| Lime                              | 2390 | 3270 |         |
| Chert & Lime                      | 3270 | 3291 |         |
| Lime                              | 3291 | 3905 |         |
| RTD                               |      | 3905 |         |


I certify that this is a true and correct copy of the above log to the best of my knowledge.

RED TIGER DRILLING COMPANY

Gloria Fawcett  
Gloria Fawcett

Subscribed and sworn to before me this 19th day of December, 1978.

Joyce A. Hagermann  
Notary Public

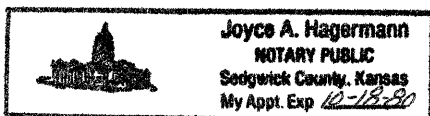

RECEIVED  
STATE CORPORATION COMMISSION  
DEC 26 1978  
12-26-1978  
CONSERVATION DIVISION  
Wichita, Kansas