


Give All Information Completely
Make Required Affidavit
Mail or Deliver Report to:
Conservation Division
State Corporation Commission
211 No. Broadway
Wichita, Kansas

WELL PLUGGING RECORD

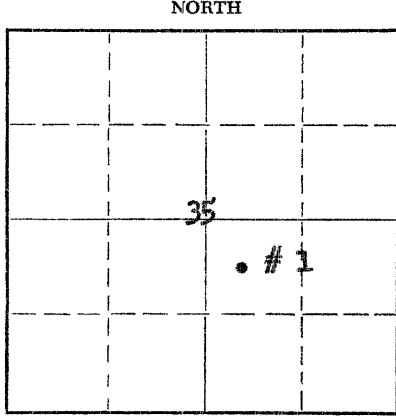

Locate well correctly on above Section Plat

Lincoln

County. Sec. 35 Twp. 10S Rge. 8W (E) (W)

Location as "NE/CNW/SW" or footage from lines Center of NW of SE/4

Lease Owner Sinclair Oil & Gas Company

Lease Name Emil Gabelmann Well No. 1

Office Address Box 521, Tulsa, Oklahoma

Character of Well (completed as Oil, Gas or Dry Hole) Completed as Dry Hole

Date well completed 5-25-60 19

Application for plugging filed 5-25-60 19

Application for plugging approved Verbal 5-25-60 19

Plugging commenced 5-25-60 19

Plugging completed 5-25-60 19

Reason for abandonment of well or producing formation Dry Hole Drilled - No commercial oil or gas found - Dry hole

If a producing well is abandoned, date of last production 19

Was permission obtained from the Conservation Division or its agents before plugging was commenced? Yes

Name of Conservation Agent who supervised plugging of this well Gilbert Toman

Producing formation None Depth to top Bottom Total Depth of Well Feet

Show depth and thickness of all water, oil and gas formations.

OIL, GAS OR WATER RECORDS

CASING RECORD

FORMATION	CONTENT	FROM	TO	SIZE	PUT IN	PULLED OUT
None encountered						

Describe in detail the manner in which the well was plugged, indicating where the mud fluid was placed and the method or methods used in introducing it into the hole. If cement or other plugs were used, state the character of same and depth placed, from feet to feet for each plug set.

Hole plugged as follows, from 419 to 300' with heavy rotary mud, Halliburton rubber plug set at 300', from 300' to 253' with 25 sacks cement, from 253' to 30' with heavy drilling mud from 30' to 11' with 10 sacks cement from 11' to surface with heavy mud, and top of 10-3/4" casing ~~removed~~ has steel cap welded on top - Rat hole filled with 5 sacks cement - Hole plugged as per Mr. Gilbert Toman's instruction - State Well Plugging Inspector.

(If additional description is necessary, use BACK of this sheet)
Name of Plugging Contractor Adkins Drilling Company
Address Great Bend, Kansas

STATE OF Kansas COUNTY OF Rice, ss.
C. B. York

(employee of owner) or (owner or operator) of the above-described well, being first duly sworn on oath, says: That I have knowledge of the facts, statements, and matters herein contained and the log of the above-described well as filed and that the same are true and correct. So help me God.

(Signature) C. B. York
C. B. York, Dist. Supt.

Box 521, 466 (Address) Chase, Kan.

SUBSCRIBED AND SWORN TO before me this 27th day of May, 1960

My commission expires August 13, 1962

RECEIVED
STATE CORPORATION COMMISSION
MAY 31 1960
CONSERVATION DIVISION
Wichita, Kansas
Notary Public. D. B. Reynolds

DRILLERS LOG

15-105-0000*5-00-00

Name of Operator - SINCLAIR OIL & GAS COMPANY

Name of Contractor - Adkins Drilling Company, Inc. Great Bend, Kansas.

Lease- Emil Gablemann No. 1

Location- NW/4 NW/4 SE/4 Sec. 35 Township 10S- Range 8 West, Lincoln Co. Kansas.

Formation	From	To
Surface soil and lime rocks	0	100
Shale & Shells	100	160
Sand & Shale	160	190
Shale & Shells	190	510
Lime	510	530

Set 10 3/4 Spiral weld pipe
at 515' cemented with 300
sacks of cement.

Cement	492	522
Sandy shale	522	850
Shale & Shells	850	1100
Lime & Shale	1100	1180
Shale & Lime	1180	1492
Lime & Shale	1492	1640
Shale & Lime	1640	1770
Lime & Shale	1770	1876
Shale & Lime	1876	2485
Lime & Shale	2485	2727

Run D S T No. 1 @ 2726' with 76'
of anchor, good blow, recovered
1444' of Water.

Lime & Shale	2727	2925
Lime	2925	3477
Lime w/ cheryt streaks	3477	3514
Lime	3514	3620
Lime w/ chert streaks	3620	3710
Lime & shale	3710	3785
Lime	3785	3815
Lime w/ streaks of chert	3815	3847
Lime	3847	3850

Run D S T No. 2 @ 3850'
Recovered ~~3850'~~ 12 ft.
of Mud.

Lime	3850	4119
------	------	------

Lost complete circulation at 4119'
Run Schlumberger test at 4119'
Run D. S. T. No. 3 at 4119' Recovered
3185' Salt Water.

Hole dry and abandoned at 4119'. T. D.

State of Kansas.)
County of Barton) ss.

Jim Adkins, of Great Bend, Kansas deposes and says that he is
President of the Adkins Drilling Company, Inc. and that the foregoing Drillers Log
is true and correct to the best of his knowledge.

Subscribed and sworn to before me this 25 day of May, 1960.

My Comm. expires 2-29-1964.

Pauline B. Adkins
Notary Public.

RECEIVED
REGISTRATION COMMISSIONER

JUN 10 1960
86-10-1960
DIVISION