


STATE OF KANSAS
STATE CORPORATION COMMISSION

Give All Information Completely
Make Required Affidavit
Mail or Deliver Report to:
Conservation Division
State Corporation Commission
212 North Market, Insurance Bldg.
Wichita, Kansas

15-105-00004-00-00
WELL PLUGGING RECORD

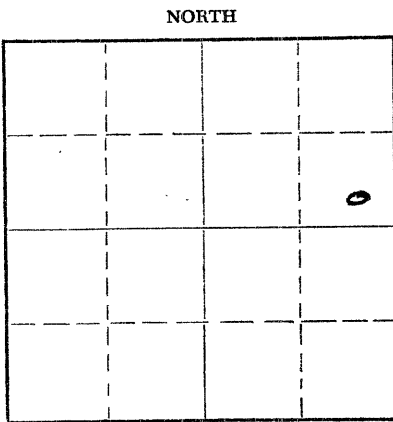

Locate well correctly on above Section Plat

Lincoln County, Sec. 32 Twp. 10S Rge. 6W (E) (W)
Location as "NE/CNW/SW" or footage from lines 430' N-S Line & 330' W-E Line
Lease Owner Harvest-Queen Mills & Elev. Co. SE 1/4 SE 1/4 NE 1/4
Lease Name Meyer Well No. 1
Office Address Plainview, Texas
Character of Well (completed as Oil, Gas or Dry Hole) Dry Hole
Date well completed June 21- 19 60
Application for plugging filed June 20- 19 60
Application for plugging approved June 21- 19 60
Plugging commenced June 21- 19 60
Plugging completed June 21- 19 60
Reason for abandonment of well or producing formation Dry Hole

If a producing well is abandoned, date of last production _____ 19____
Was permission obtained from the Conservation Division or its agents before plugging was commenced? yes

Name of Conservation Agent who supervised plugging of this well Gilbert J. Toman, Holyrood, Kansas.
Producing formation _____ Depth to top _____ Bottom _____ Total Depth of Well 4155 Feet
Show depth and thickness of all water, oil and gas formations.

OIL, GAS OR WATER RECORDS

CASING RECORD

FORMATION	CONTENT	FROM	TO	SIZE	PUT IN	PULLED OUT
<u>Shale sand</u>	<u>Lime</u>	<u>0</u>	<u>504</u>	<u>8 5/8</u>	<u>504'</u>	<u>None</u>

Describe in detail the manner in which the well was plugged, indicating where the mud fluid was placed and the method or methods used in introducing it into the hole. If cement or other plugs were used, state the character of same and depth placed, from _____ feet to _____ feet for each plug set.

Hole filled with Heavy mud from 4155' to 250'. Set Wood plug at 250', cemented by Halliburton Oil Well Cementing Company, thru the drill pipe with 20 sacks of cement. Heavy mud from top of cement to 30'. Set wood plug at 30 ft. and cemented thru Drill Pipe with 12 sacks of Cement.

Well was plugged in accordance with instructions of Gilbert J. Toman, of State Corporation Commission, who was present at the time of plugging well.

RECEIVED
STATE CORPORATION COMMISSION

SEP 12 1960
09-12-1960
CONSERVATION DIVISION
Wichita, Kansas

(If additional description is necessary, use BACK of this sheet)

Name of Plugging Contractor Adkins Drilling Company, Inc.
Address Great Bend, Kansas.

STATE OF Texas, COUNTY OF Hale, ss.

(employee of owner) or (owner or operator) of the above-described well, being first duly sworn on oath, says: That I have knowledge of the facts, statements, and matters herein contained and the log of the above-described well as filed and that the same are true and correct. So help me God.
(Signature) J Roy M Coy

(Address)

SUBSCRIBED AND SWORN TO before me this 6th day of September, 19 60

Leona Bates

LEONA BATES
Notary Public, Hale County, Texas
Commission Expires June 1, 1961

My commission expires 6/1/61

