


WELL PLUGGING RECORD

Give All Information Completely
Make Required Affidavit
Mail or Deliver Report to:
Conservation Division
State Corporation Commission
211 No. Broadway
Wichita, Kansas

Lincoln County. Sec. 1 Twp. 10 Rge. 6 (E) W (W)
Location as "NE/CNW $\frac{1}{4}$ SW $\frac{1}{4}$ " or footage from lines SW/4 SW/4 NE/4
Lease Owner Oil Capital Corporation
Lease Name Shilling Well No. 1
Office Address 1001 First National Bldg. - Tulsa 3, Oklahoma
Character of Well (completed as Oil, Gas or Dry Hole) Dry Hole
Date well completed July 14 19 56
Application for plugging filed July 14 19 56
Application for plugging approved July 14 19 56
Plugging commenced July 14 19 56
Plugging completed July 14 19 56
Reason for abandonment of well or producing formation _____

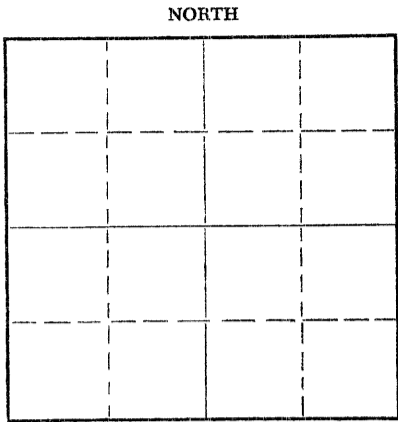

Locate well correctly on above Section Plat

If a producing well is abandoned, date of last production _____ 19____
Was permission obtained from the Conservation Division or its agents before plugging was commenced? Yes

Name of Conservation Agent who supervised plugging of this well Milton Galyardt
Producing formation _____ Depth to top _____ Bottom _____ Total Depth of Well 4053 Feet
Show depth and thickness of all water, oil and gas formations.

OIL, GAS OR WATER RECORDS

CASING RECORD

FORMATION	CONTENT	FROM	TO	SIZE	PUT IN	PULLED OUT
				8 5/8"	350'	cmtd w/175 sax

Describe in detail the manner in which the well was plugged, indicating where the mud fluid was placed and the method or methods used in introducing it into the hole. If cement or other plugs were used, state the character of same and depth placed, from _____ feet to _____ feet for each plug set.

Circulate hole with heavy mud
Set bridge plug and 1/2 sax hulls @ 270' and cement w/20 sax through drill pipe
Heavy mud to 40'
Set bridge plug and 1/2 sax hulls @ 40' and cement w/10 sax to bottom of cellar

(If additional description is necessary, use BACK of this sheet)
Name of Plugging Contractor Shields Drilling Company, Inc.
Address Shields Building-Russell, Kansas

STATE OF Kansas, COUNTY OF Russell, ss.
R. J. Shields, contractor (Employee of Owner) or (Owner or Operator) of the above-described well, being first duly sworn on oath, says: That I have knowledge of the facts, statements, and matters herein contained and the log of the above-described well as filed and that the same are true and correct. So help me God.

(Signature) *R. J. Shields*
Shields Building-Russell, Kansas
(Address)

SUBSCRIBED AND SWORN TO before me this 17th day of July, 19 56

My commission expires 12-18-1957

Jack P. Beeman
Notary Public.

PLUGGING
FILE SEC. 1 T. 10 R. 6 W.
BOOK PAGE 81 L. E. 13

07-18-1956




Shields

Russell, Kansas

WELL LOG

Operator: Oil Capital Corporation
 Well: Shilling #1
 Commenced: June 28, 1956
 Completed: July 15, 1956
 Contractor: Shields Drilling Co., Inc.

Well Description:

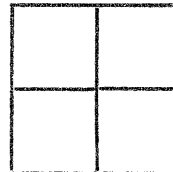

SW SW NE
 Sec. 1-10S-6W
 Lincoln County, Kansas

CASING RECORD

Size	Run	Pulled
8 5/8"	350'	Cmtd. with 175 sax

Elevation: 1531' D.F.

Treatment:

Production: D&A

Tops:

15-105-00003-00-00

..... Figures Indicate Bottom of Formations

Top Soil & Lime Rock	45
Shale	125
Sand	160
Sandy Shale	575
Red Bed	670
Shale	805
Lime & Shale	1025
Shale & Lime	1205
Shale & Lime Streaks	1330
Lime and Shale	1530
Shale & Lime	1755
Shale	2195
Lime and Shale	2340
Shale and Lime	2605
Lime	2997
Lime and Shale	3103
Shale	3190
Cong. and Shale	3234
Lime	3519
Shale and Chert	3565
Chert and Lime	3619
Lime	3713
Shale and Lime	3756
Lime	4053 RTD

Notes

PLUGGING
FILE SEC. <u>1</u> T. <u>10</u> R. <u>6W</u>
BOOK PAGE <u>81</u> LINE <u>13</u>

07-18-1956