

CARD MUST BE TYPED

State of Kansas **NOTICE OF INTENTION TO DRILL** (see rules on reverse side)

CARD MUST BE SIGNED

Starting Date: 3 29 85
 month day year

API Number 15- 207-01,003-00-01

OPERATOR: License # 5150
 Name Mack C. Colt, Inc.
 Address P.O. Box 388
 City/State/Zip Iola, KS 66749
 Contact Person Dennis Kershner
 Phone 316-365-3111

NW NE NE Sec 23 Twp 26 S, Rge 14 ☒ East
 (location) ☐ West

4880 Ft North from Southeast Corner of Section
 1110 Ft West from Southeast Corner of Section
 (Note: Locate well on Section Plat on reverse side)

CONTRACTOR: License # 5150
 Name company tools
 City/State

Nearest lease or unit boundary line 185 feet.

County Woodson

Lease Name Allen Well# 2

Domestic well within 330 feet: ☐ yes ☒ no

Municipal well within one mile: ☐ yes ☒ no

Well Drilled For:	Well Class:	Type Equipment:
☐ Oil ☐ Swd	☒ Infield	☒ Mud Rotary
☐ Gas ☐ Inj	☐ Pool Ext.	☐ Air Rotary
☒ OWWO ☐ Expl	☐ Wildcat	☐ Cable

Depth to Bottom of fresh water unknown feet

Lowest usable water formation unknown

Depth to Bottom of usable water 225 feet

Surface pipe by Alternate: 1 ☐ 2 ☒

Surface pipe to be set 40 feet

Conductor pipe if any required none feet

Ground surface elevation 927 feet MSL

This Authorization Expires 9-26-85

Approved By 3-26-85

If OWWO: old well info as follows: To be plugged.

Operator Mack C. Colt, Inc.

Well Name Allen 2

Comp Date Est. 1928 Old Total Depth 1300

Projected Total Depth 1300 feet

Projected Formation at TD Bartlesville

Expected Producing Formations Bartlesville


I certify that we will comply with K.S.A. 55-101, et seq., plus eventually plugging hole to K.C.C. specifications.

Date 3-25-85 Signature of Operator or Agent

Title Agent

Must be filed with the K.C.C. five (5) days prior to commencing well
This card void if drilling not started within six (6) months of date received by K.C.C.

A Regular Section of Land
1 Mile = 5,280 Ft.

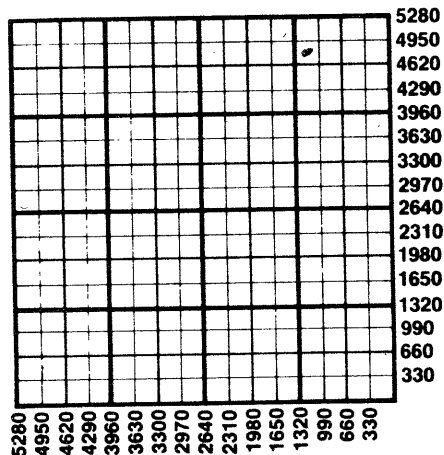

Important procedures to follow:

1. Notify District office before setting surface casing.
2. Set surface casing by circulating cement to the top.
3. File completion forms ACO-1 with K.C.C. within 90 days of well completion, following instructions on ACO-1, side 1, and including copies of wireline logs.
4. Notify District office 48 hours prior to old well workover or re-entry.
5. Prior to plugging, prepare a plugging plan, then obtain agreement from the appropriate district office for an approved plugging plan.
6. Submit plugging report (CP-4) to K.C.C. after plugging is completed.
7. Obtain an approved injection docket number before disposing of salt water.
8. Notify K.C.C. within 10 days when injection commences or terminates.
9. If an alternate 2 completion, cement in the production pipe from below any usable water to surface within 120 days of spud date.

State Corporation Commission of Kansas
Conservation Division
200 Colorado Derby Building
Wichita, Kansas 67202
(316) 263-3238

RECEIVED
STATE CORPORATION COMMISSION

MAR 2
3-26-85

CONSERVATION DIVISION
Wichita, Kansas

RECEIVED
STATE CORPORATION COMMISSION

MAR 2 6 10 PM '85
CONSERVATION DIVISION
Wichita, Kansas